


BY EMM DATE 11-2-55 SUBJECT T/O - Florida Ave

SHEET NO. _____ OF _____


CHKD. BY _____ DATE _____

JOB NO. 500-27-21-20

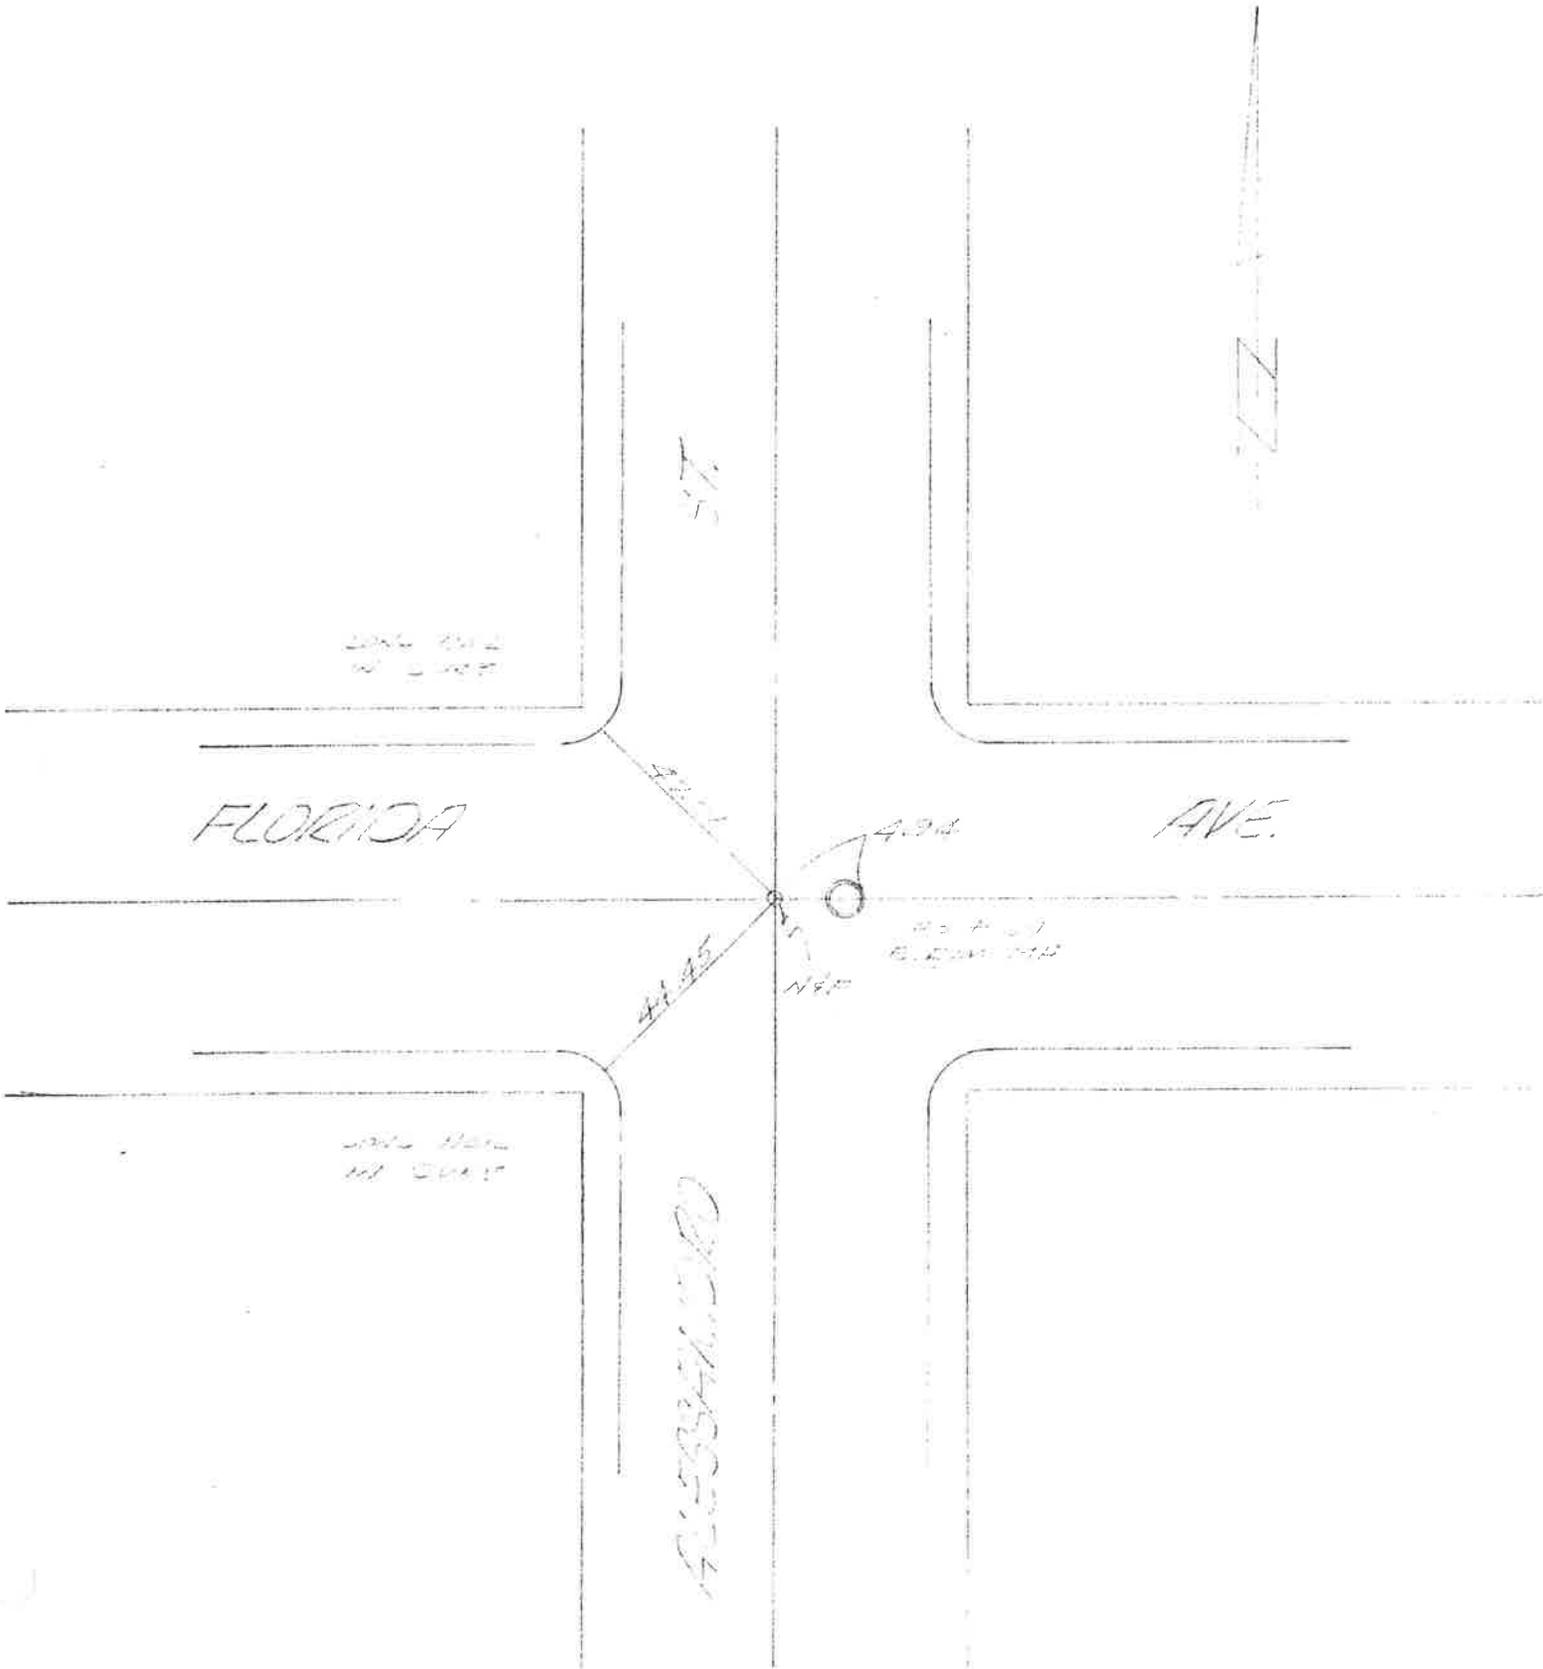

MONUMENT TIES

SECTION 10 TWP 5S RANGE 1W

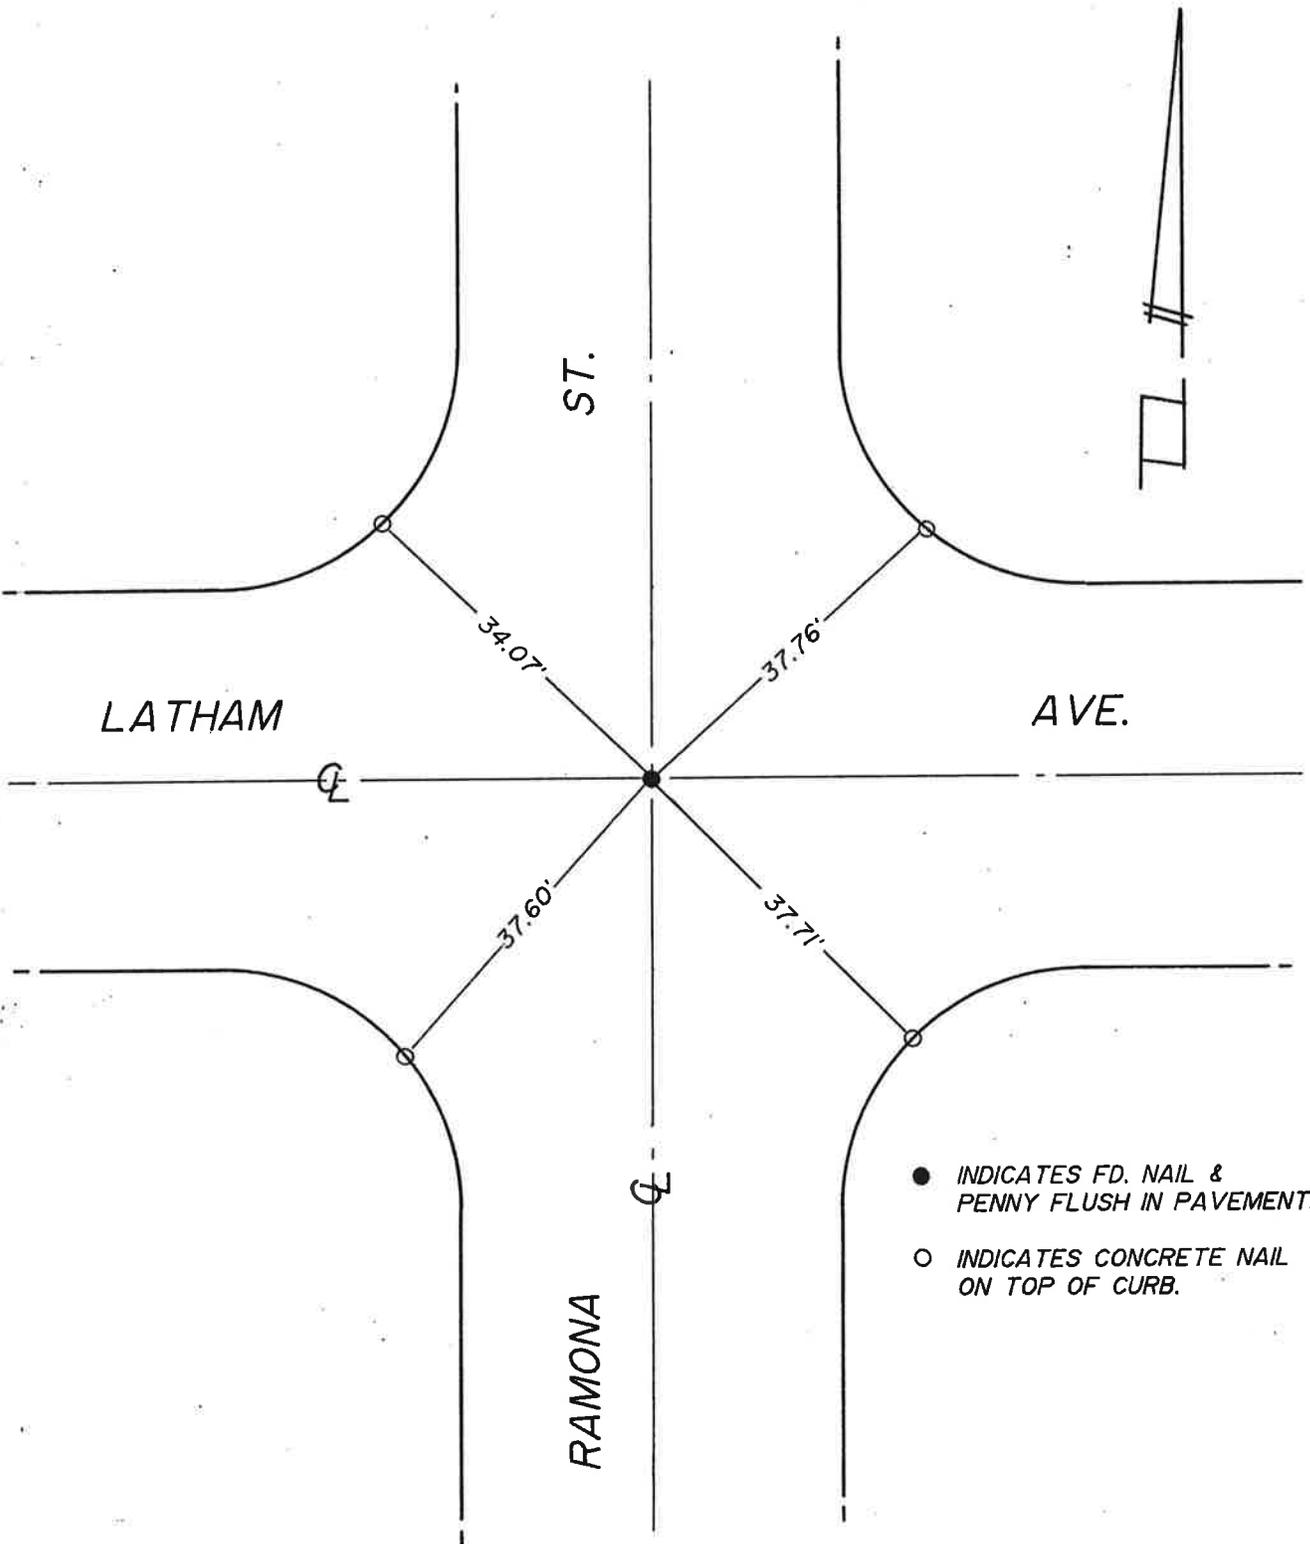

- INDICATES FD. NAIL & PENNY FLUSH IN PAVEMENT.
- INDICATES CONCRETE NAIL ON TOP OF CURB.


City of Hemet



480 EAST LATHAM AVENUE • HEMET, CALIFORNIA 92343 • (714) 958-9411

MONUMENT TIES

SECTION 10 TOWNSHIP 5S RANGE 1W

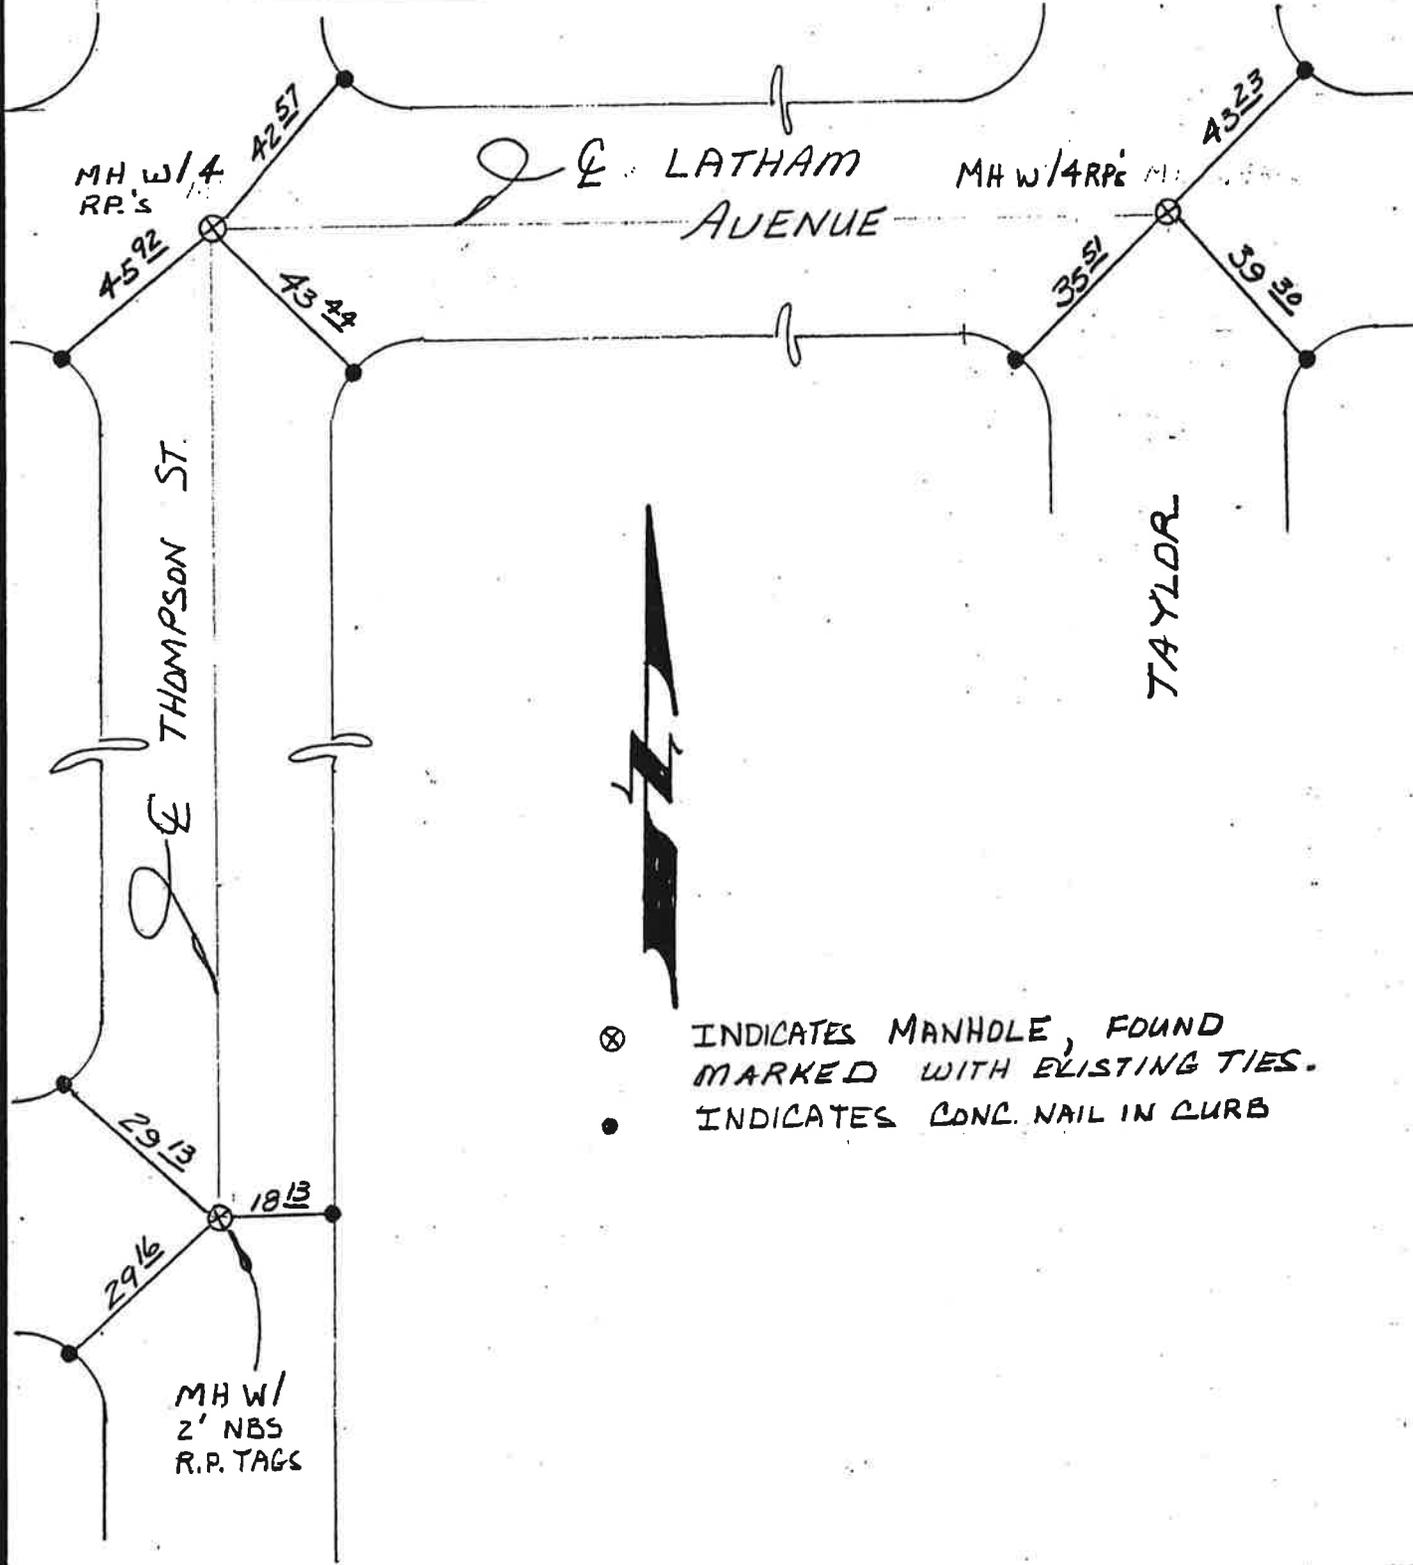

City of Hemet
450 E. Latham Ave., Hemet, CA 92343

(618)

BY ERH

DATE 9/28/66

SUBJECT Ties to Devonshire Ave.

SHEET NO. OF

CHKD BY

DATE

E Inez St.
Dist. 64-4

JOB NO 59-967-004-16

DEVONSHIRE

AVE.

20.95'

1 1/4" IP
RCE 12116

37.71

37.52

NOTE: TIES ARE TO
CONC. NAILS IN CURB


INEZ

ST.



MONUMENT TIES

SECTION 10 TWP 5S RANGE 1W

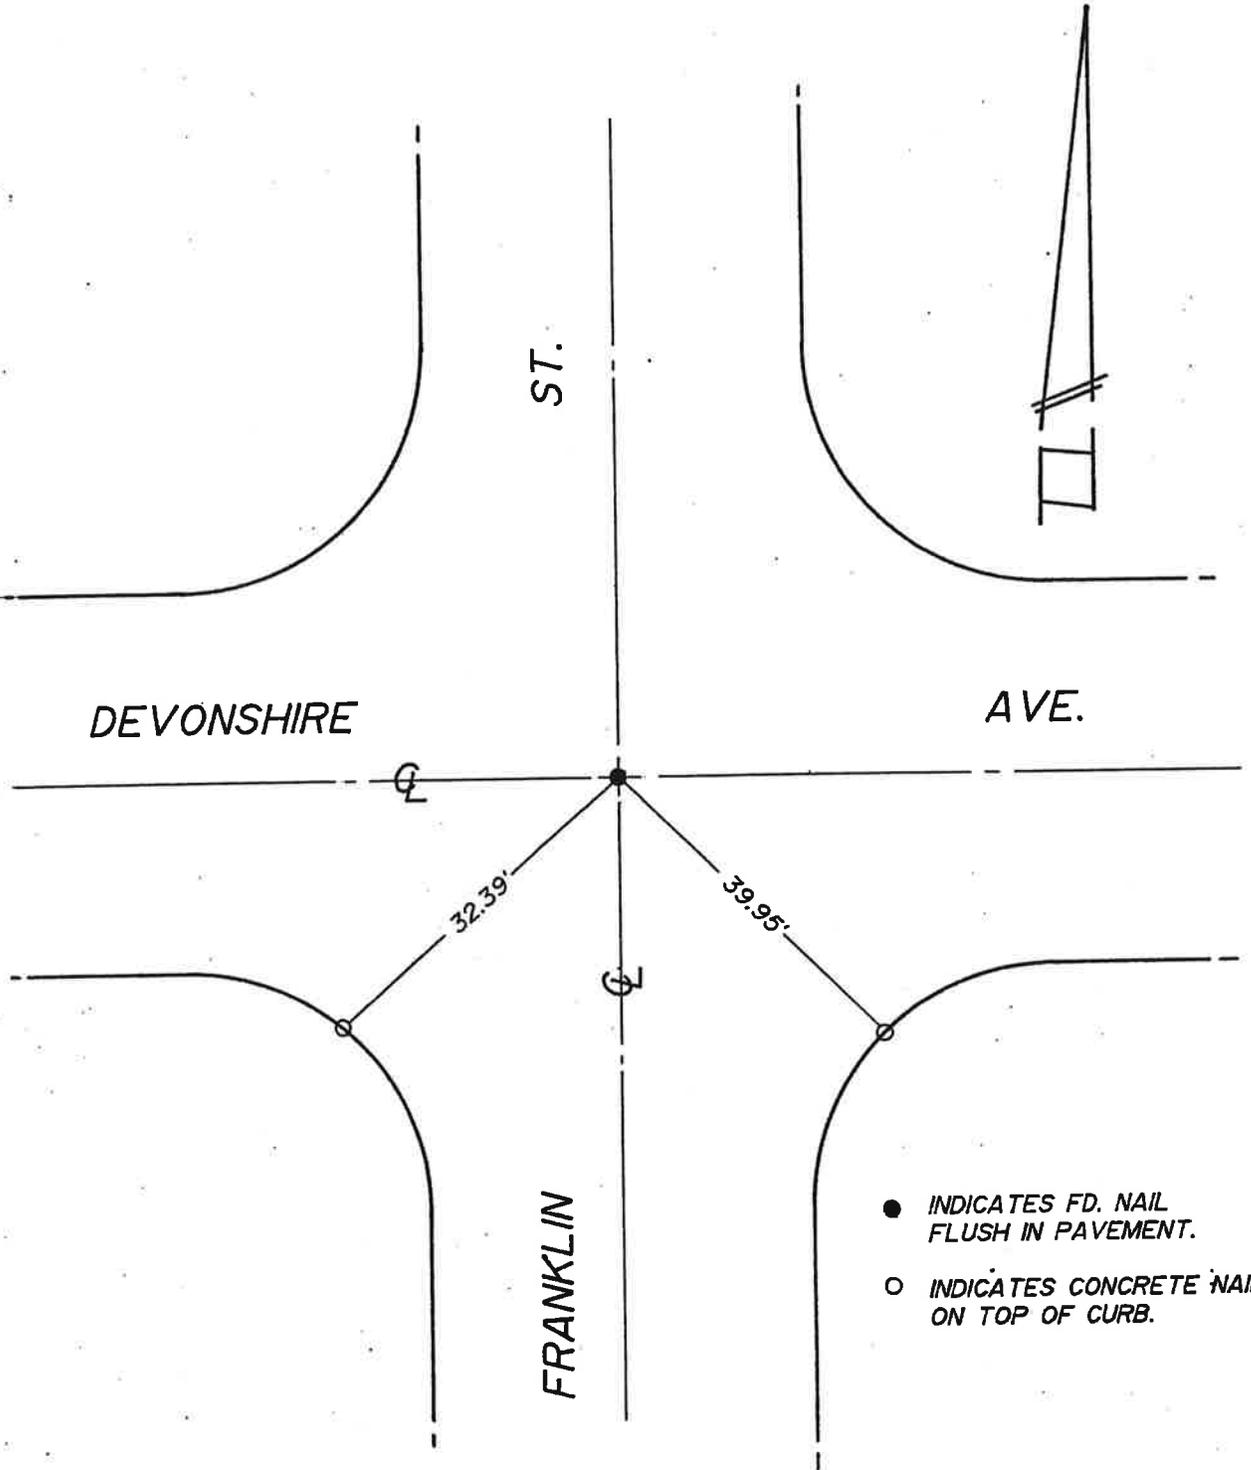

- INDICATES FD. NAIL FLUSH IN PAVEMENT.
- INDICATES CONCRETE NAIL ON TOP OF CURB.


City of Hemet



400 EAST LATMAN AVENUE - HEMET, CALIFORNIA 92343 - (714) 930-2611

MONUMENT TIES

SECTION 10 TWP 5S RANGE 1W

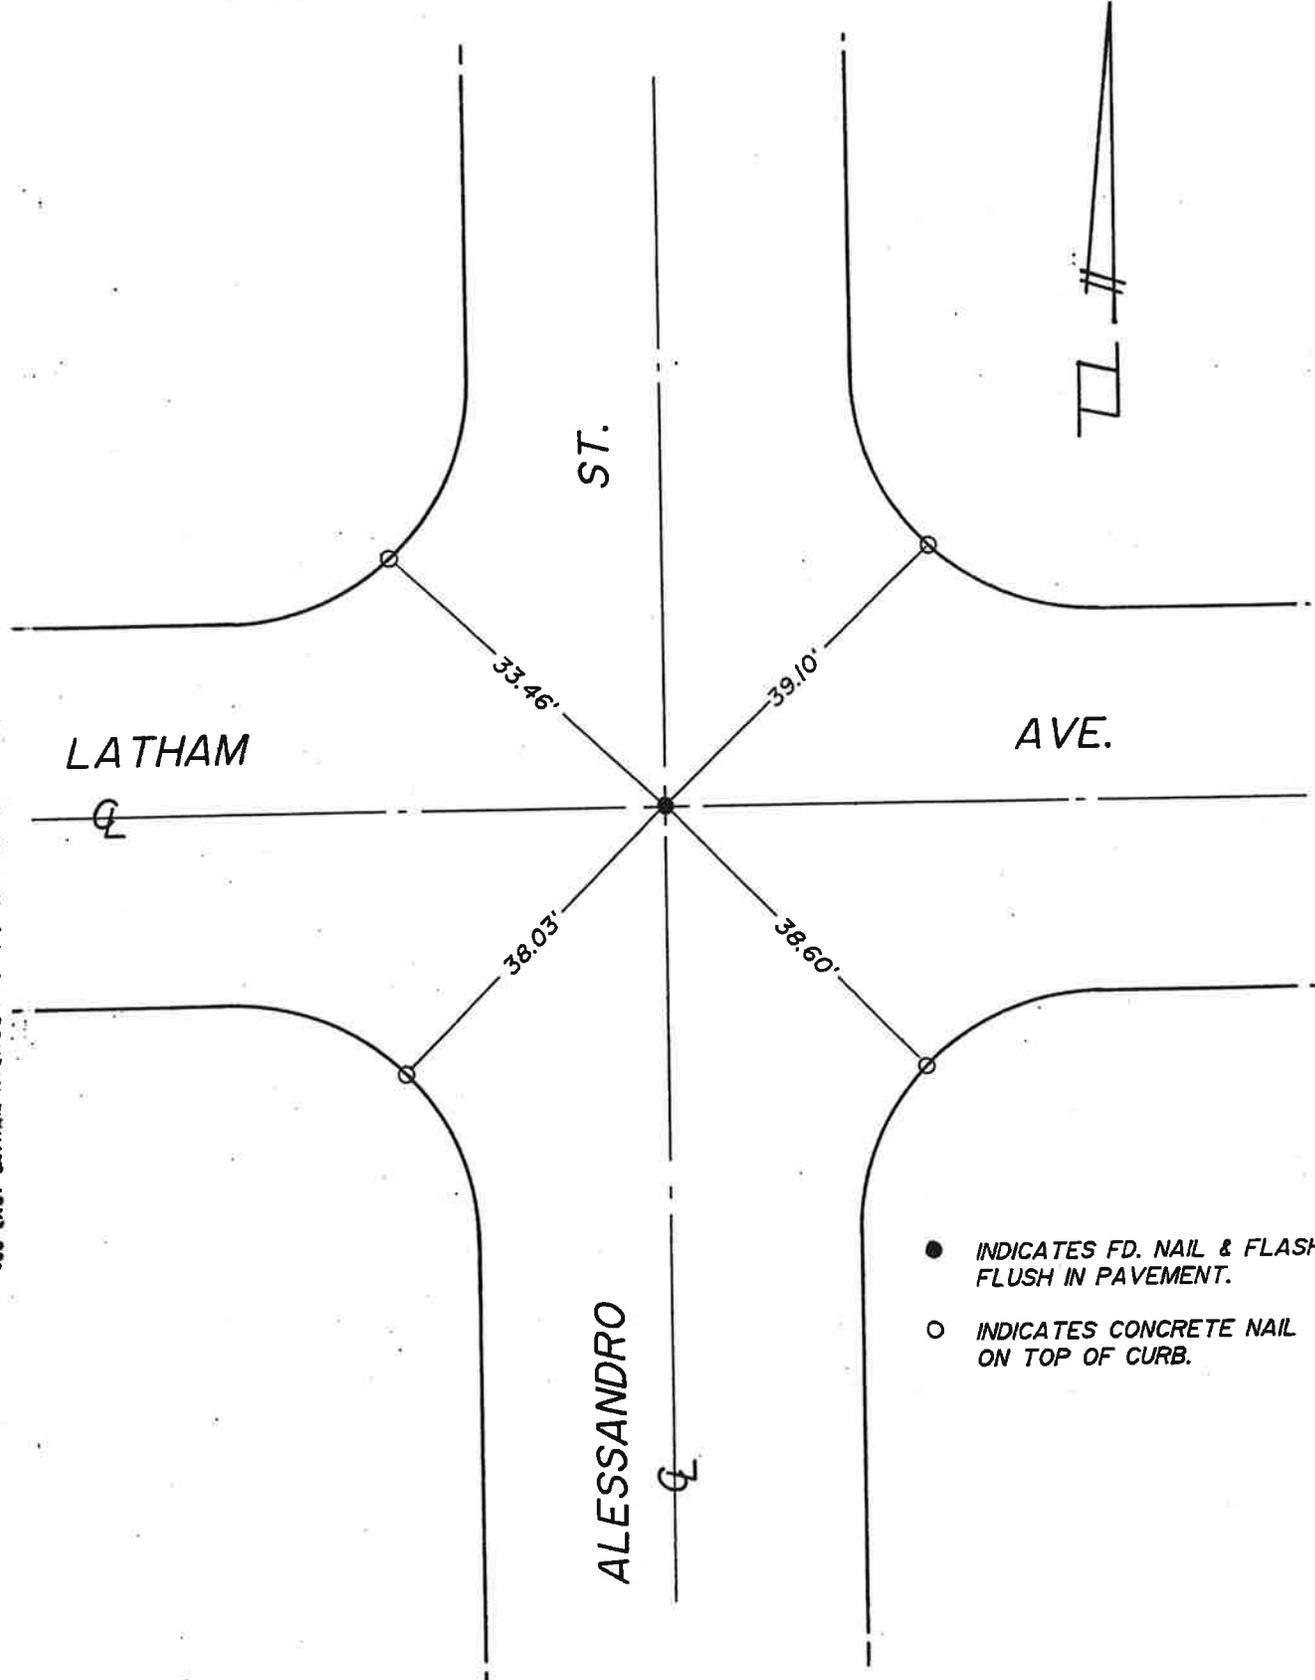

LATHAM

AVE.

ST.

ALESSANDRO

- INDICATES FD. NAIL & FLASH FLUSH IN PAVEMENT.
- INDICATES CONCRETE NAIL ON TOP OF CURB.


City of Hemet

888 EAST LATHAM AVENUE • HEMET, CALIFORNIA 92343 • (714) 950-9411



MONUMENT TIES

SECTION 10 TWP 5S RANGE 1W

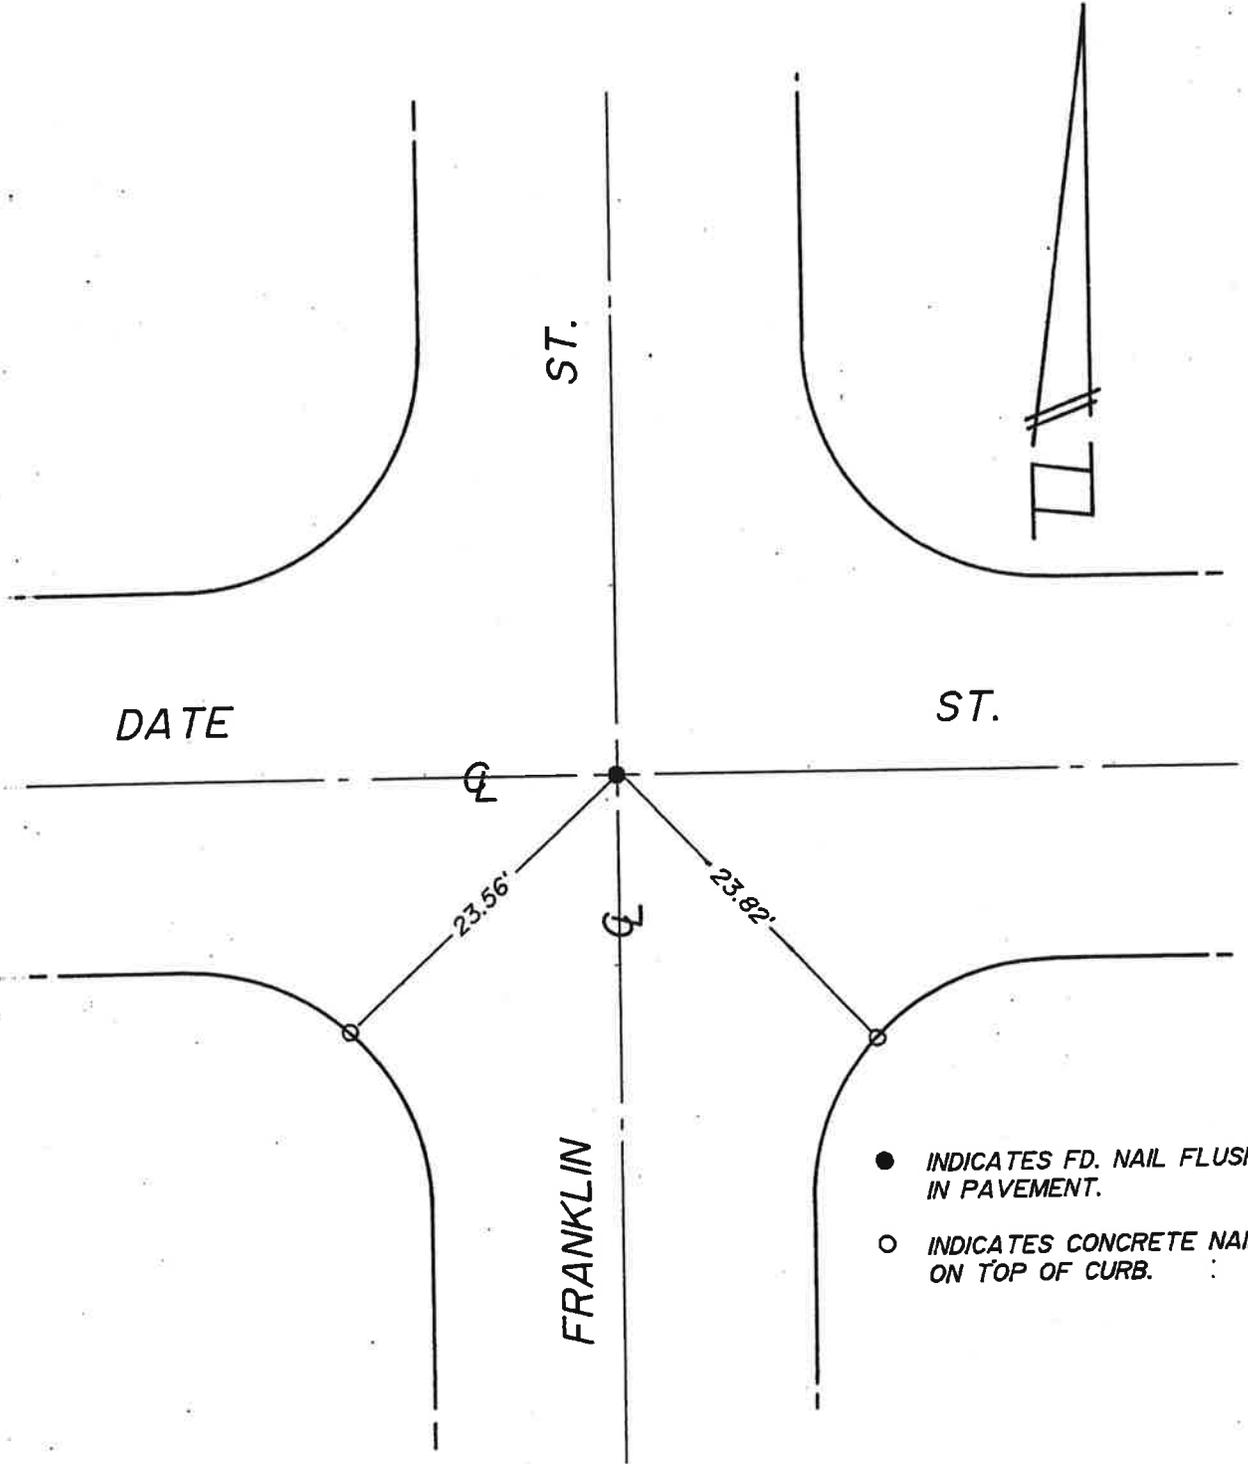

- INDICATES FD. NAIL FLUSH IN PAVEMENT.
- INDICATES CONCRETE NAIL ON TOP OF CURB.

City of Hemet



400 EAST LATHAM AVENUE • HEMET, CALIFORNIA 92343 • (714) 658-0617

NESTE, BRUDIN & STONE
CIVIL ENGINEERS
SAN BERNARDINO COUNTY

DATE 10-29-70


JCS NO _____

BY M.L. CHK'D _____

SHEET _____ OF _____

FRANKLIN ST & DATE ST

R.C.E.

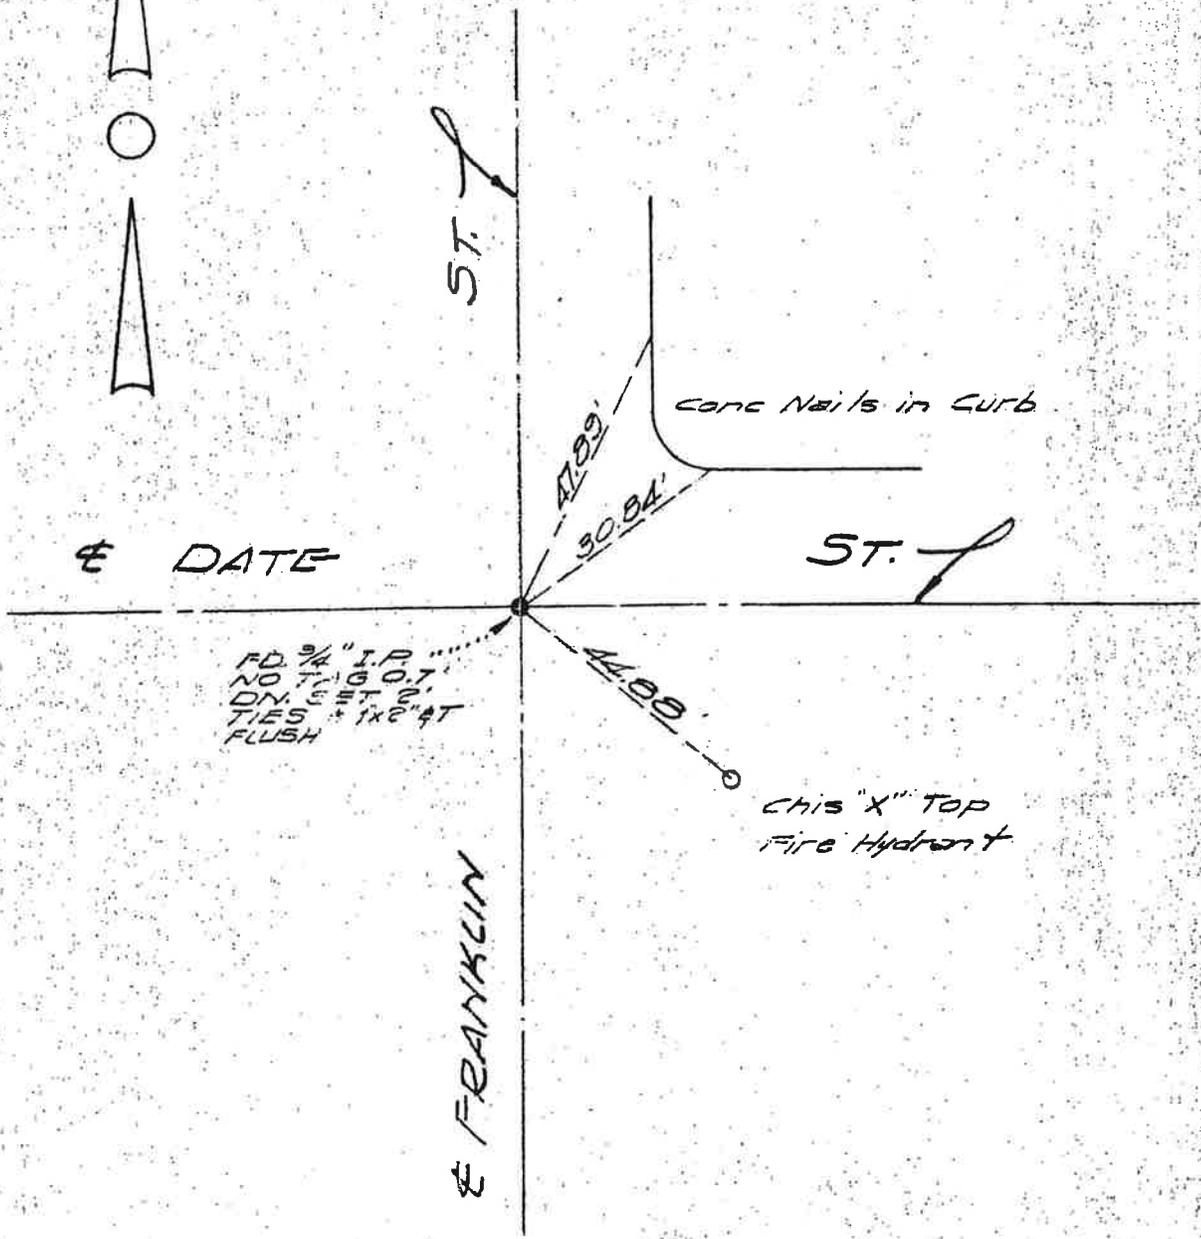

FD 3/4" I.P.
NO TIE 6.07'
DN. SET 2'
TIES * 1X2" AT
FLUSH

this "X" TOP
Fire Hydrant

NESTE, BRUDIN & STONE
CIVIL ENGINEERS
SAN BERNARDINO HENET

DATE 10-29-70


DATE ST. & THOMPSON ST.

JOB NO. _____

BY M.L. CHK'D _____

SHEET _____ OF _____


R.C.E.

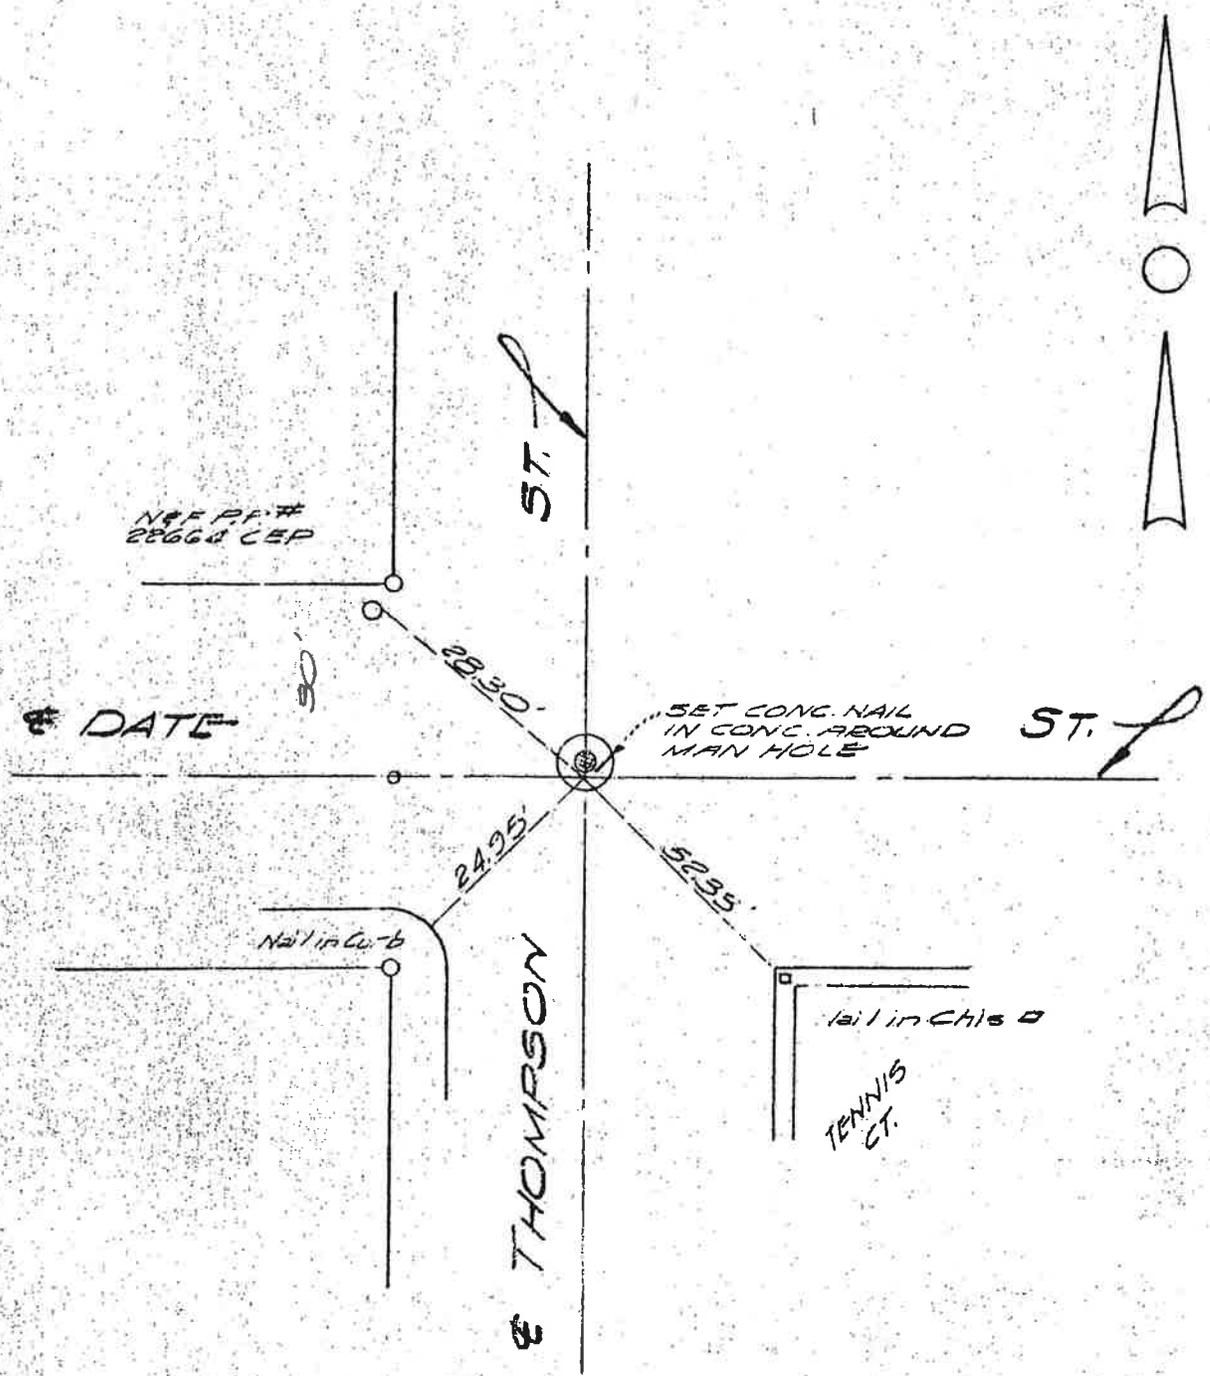

BY *FRH* DATE *6/28/60*
CHKD. BY DATE


SUBJECT *Ties to Latham A. S.E.*
Las Lunas St.
Dist. 64-2

ARREST NO. OF
JOB NO. *59-067-002-16*

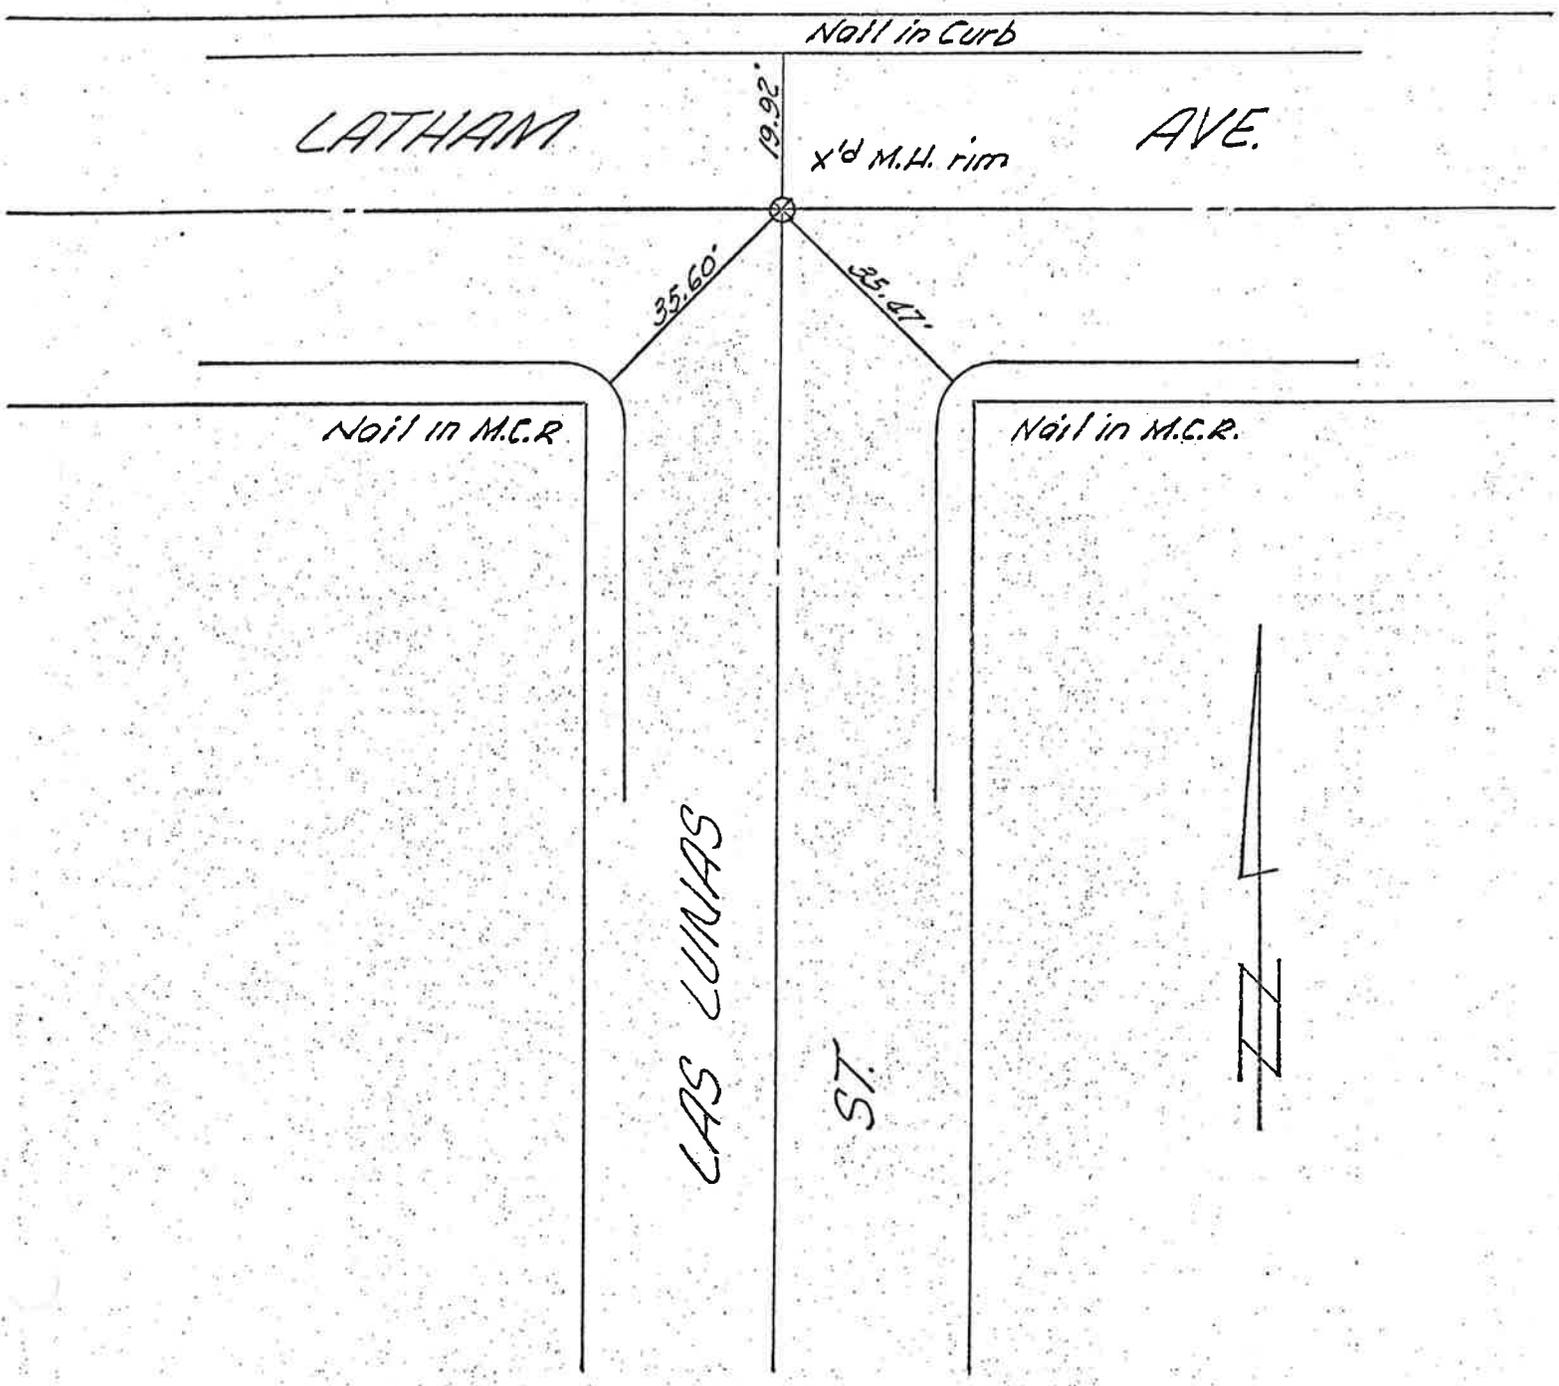

MONUMENT TIES

SECTION 10 TWP 5S RANGE 1W

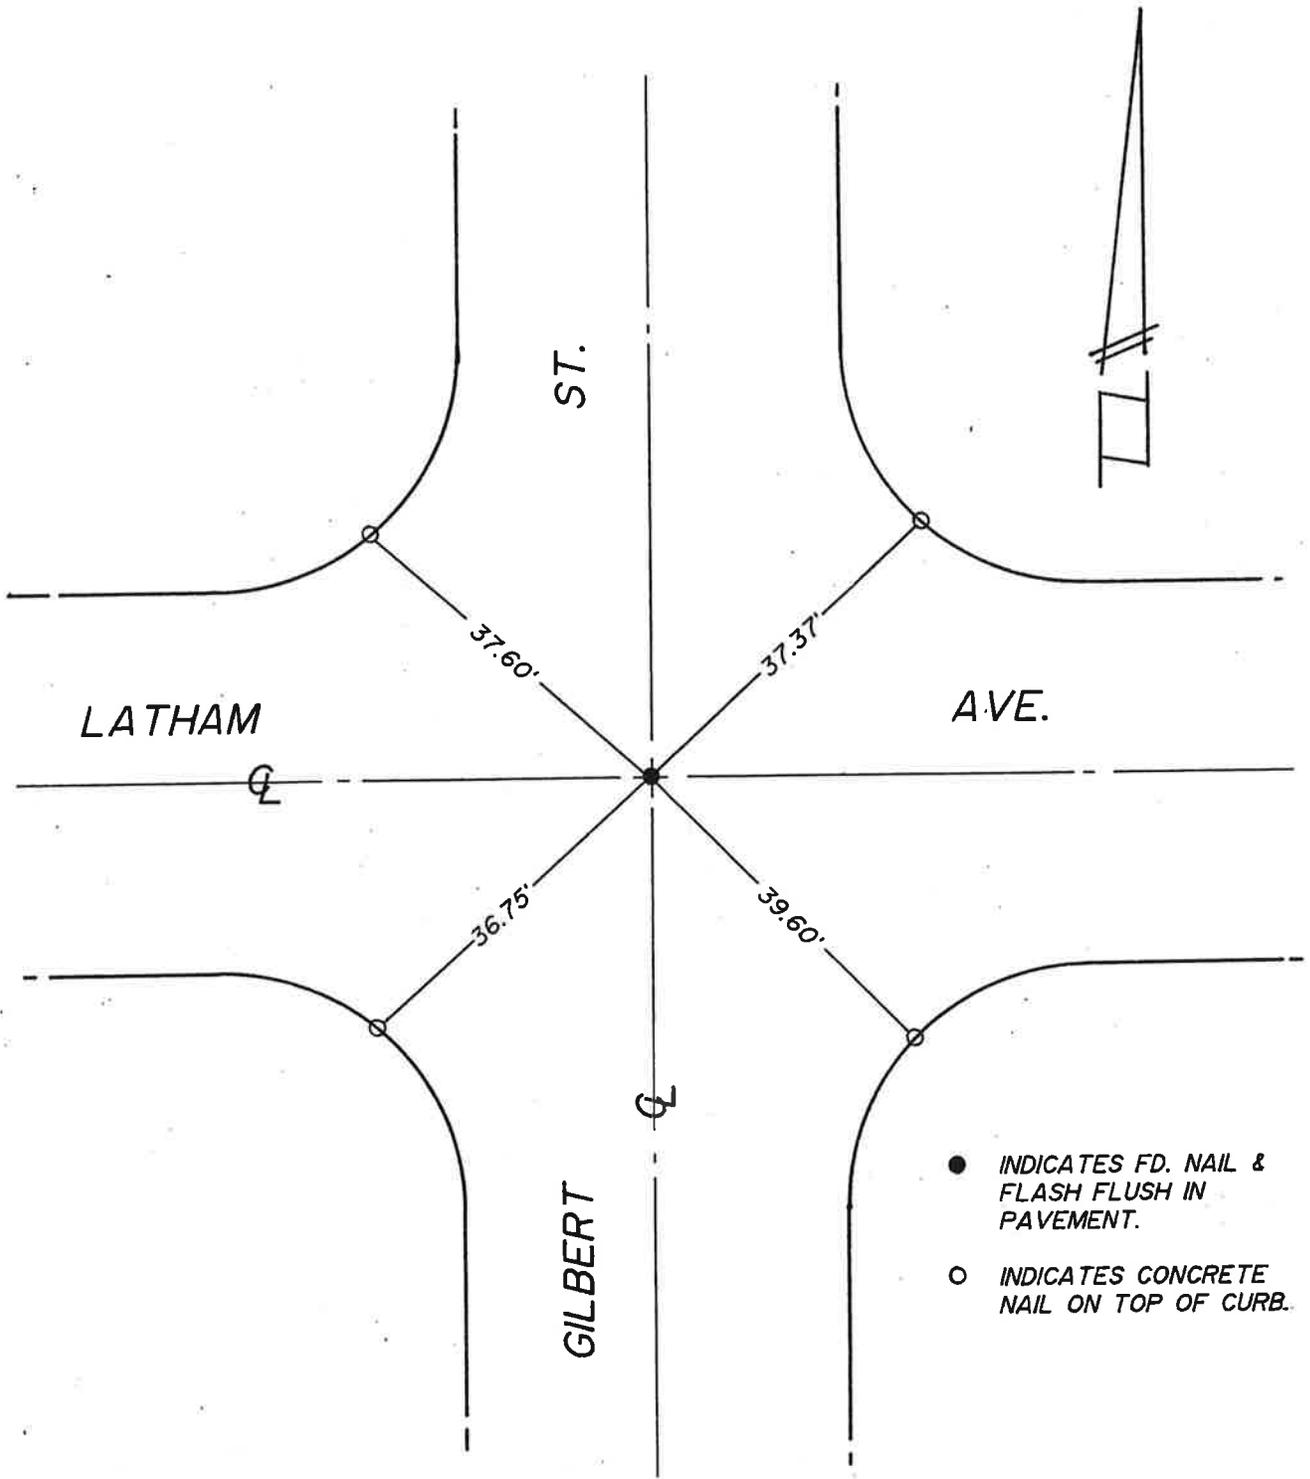

City of Hemet




955 EAST LATHAM AVENUE • HEMET, CALIFORNIA 92343 • (714) 958-0411

- INDICATES FD. NAIL & FLASH FLUSH IN PAVEMENT.
- INDICATES CONCRETE NAIL ON TOP OF CURB.

PL. FRH DATE 6/28/16
CLAS. BY DATE

PL. 504 Ties to Devonshire Ave.
Tahquitz Ave.
Dist. 64-2

SHEET NO. 057
JOB NO. 59-067-002-16

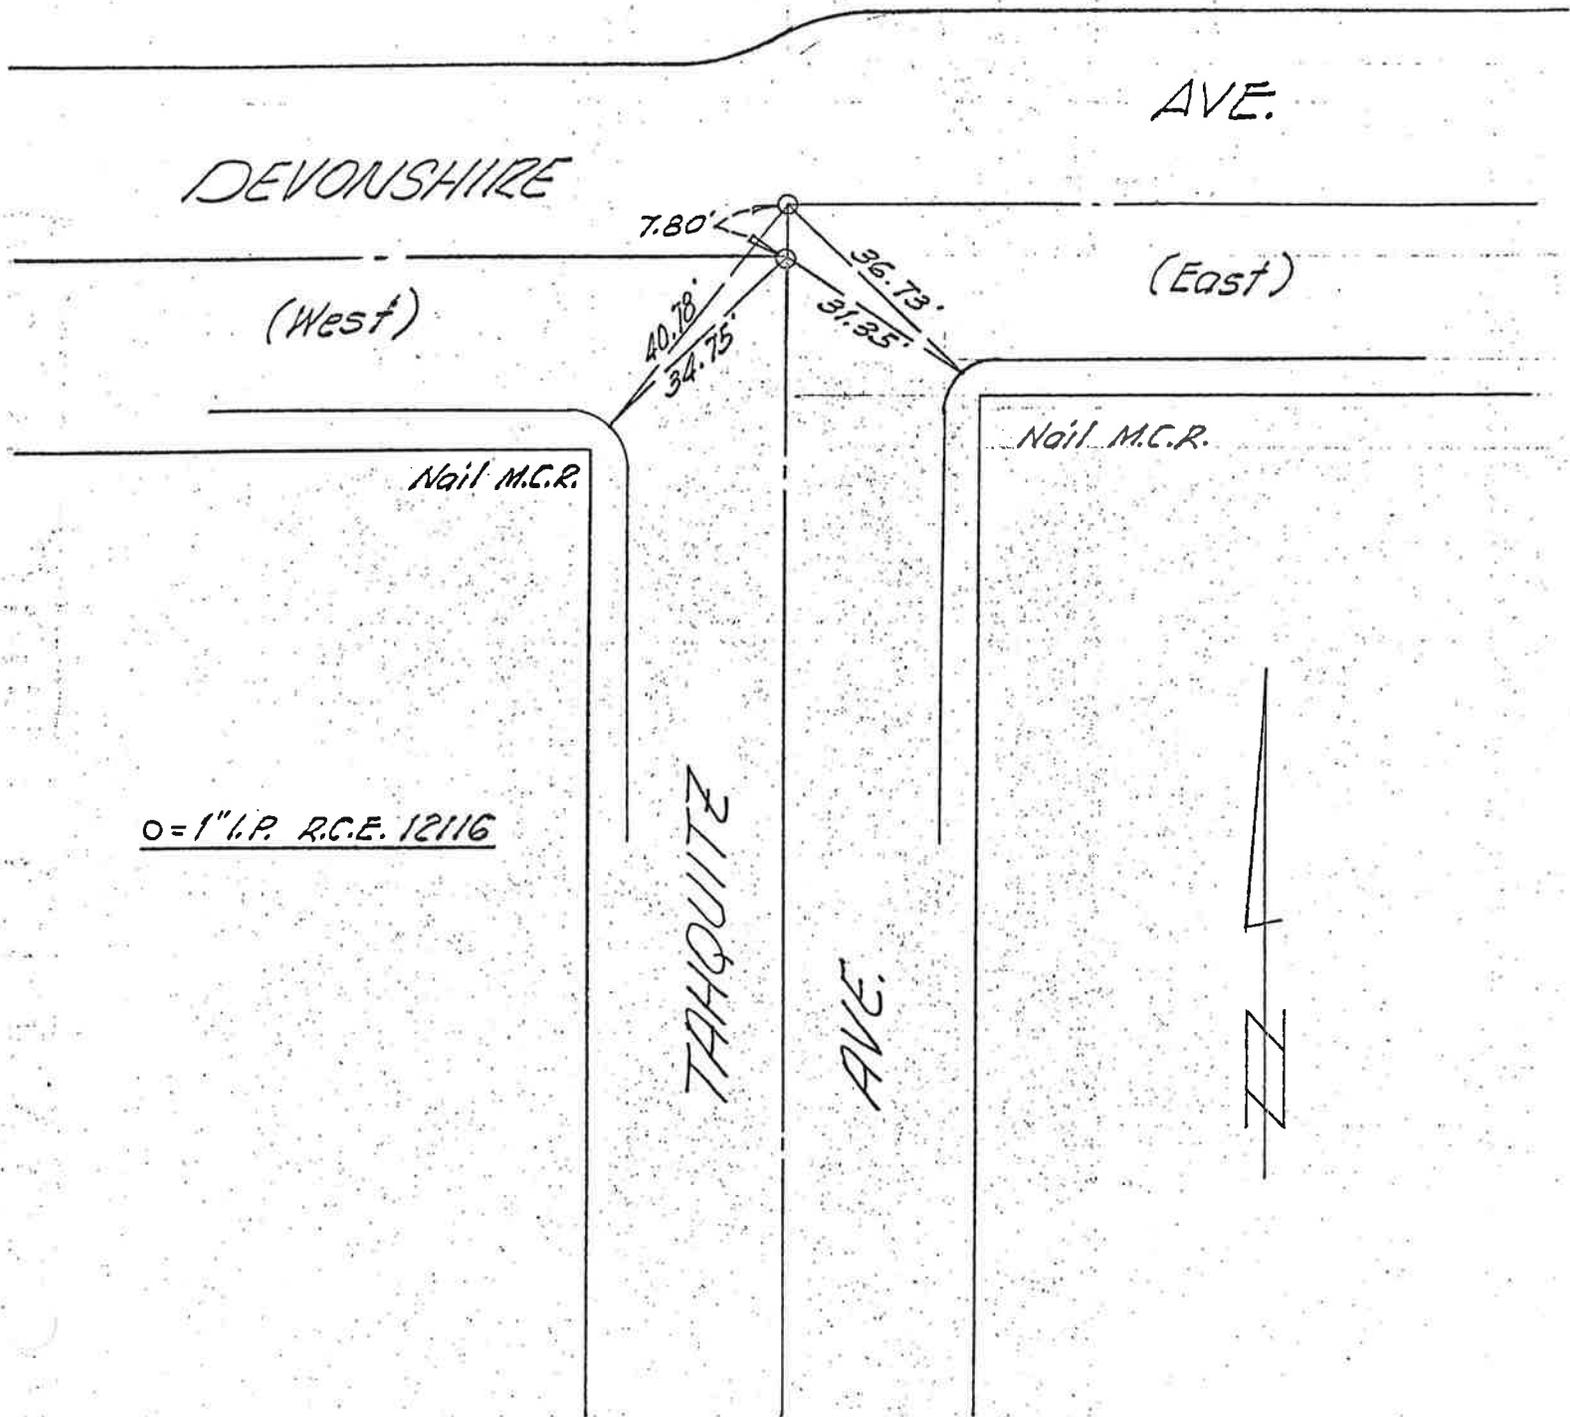

1" = 100' R.C.E. 12116

BY FRH.

DATE 6/23/56

PROJECT Ties to Latham Ave. &

BLK. NO. 07

EXPLAN. SHEET


DATE

Tahquitz Ave.


JOB NO. 59-067-002-16

SCALE

Dist. 64-2

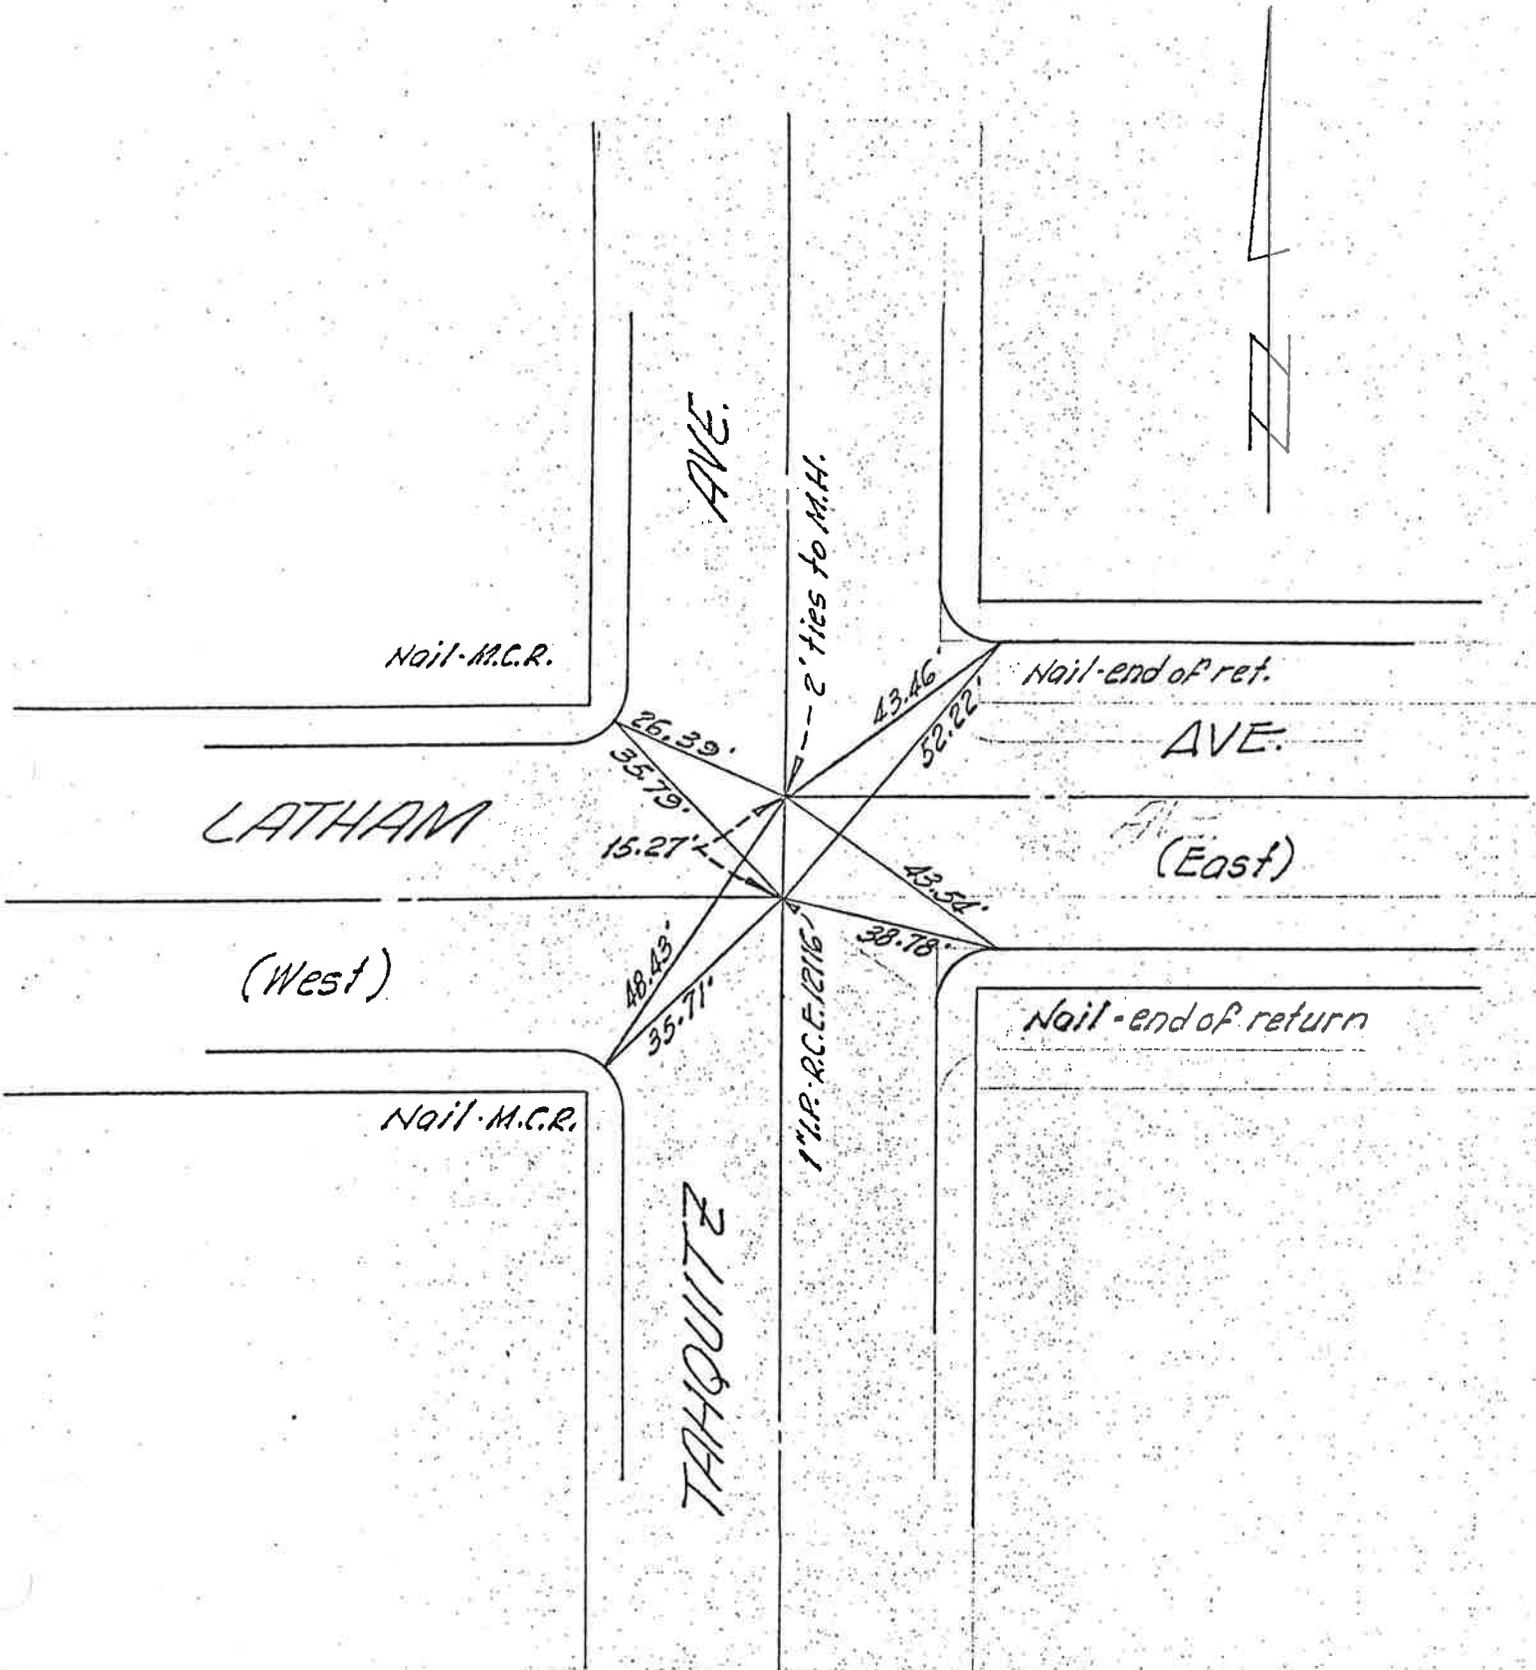

FRH. DATE 6/28/62 TIES TO LATHAM R. & E. DIST. 64-2
CANCELED BY DATE GILBERT ST. DIST. 64-2
JOB NO. 59-057-002-16

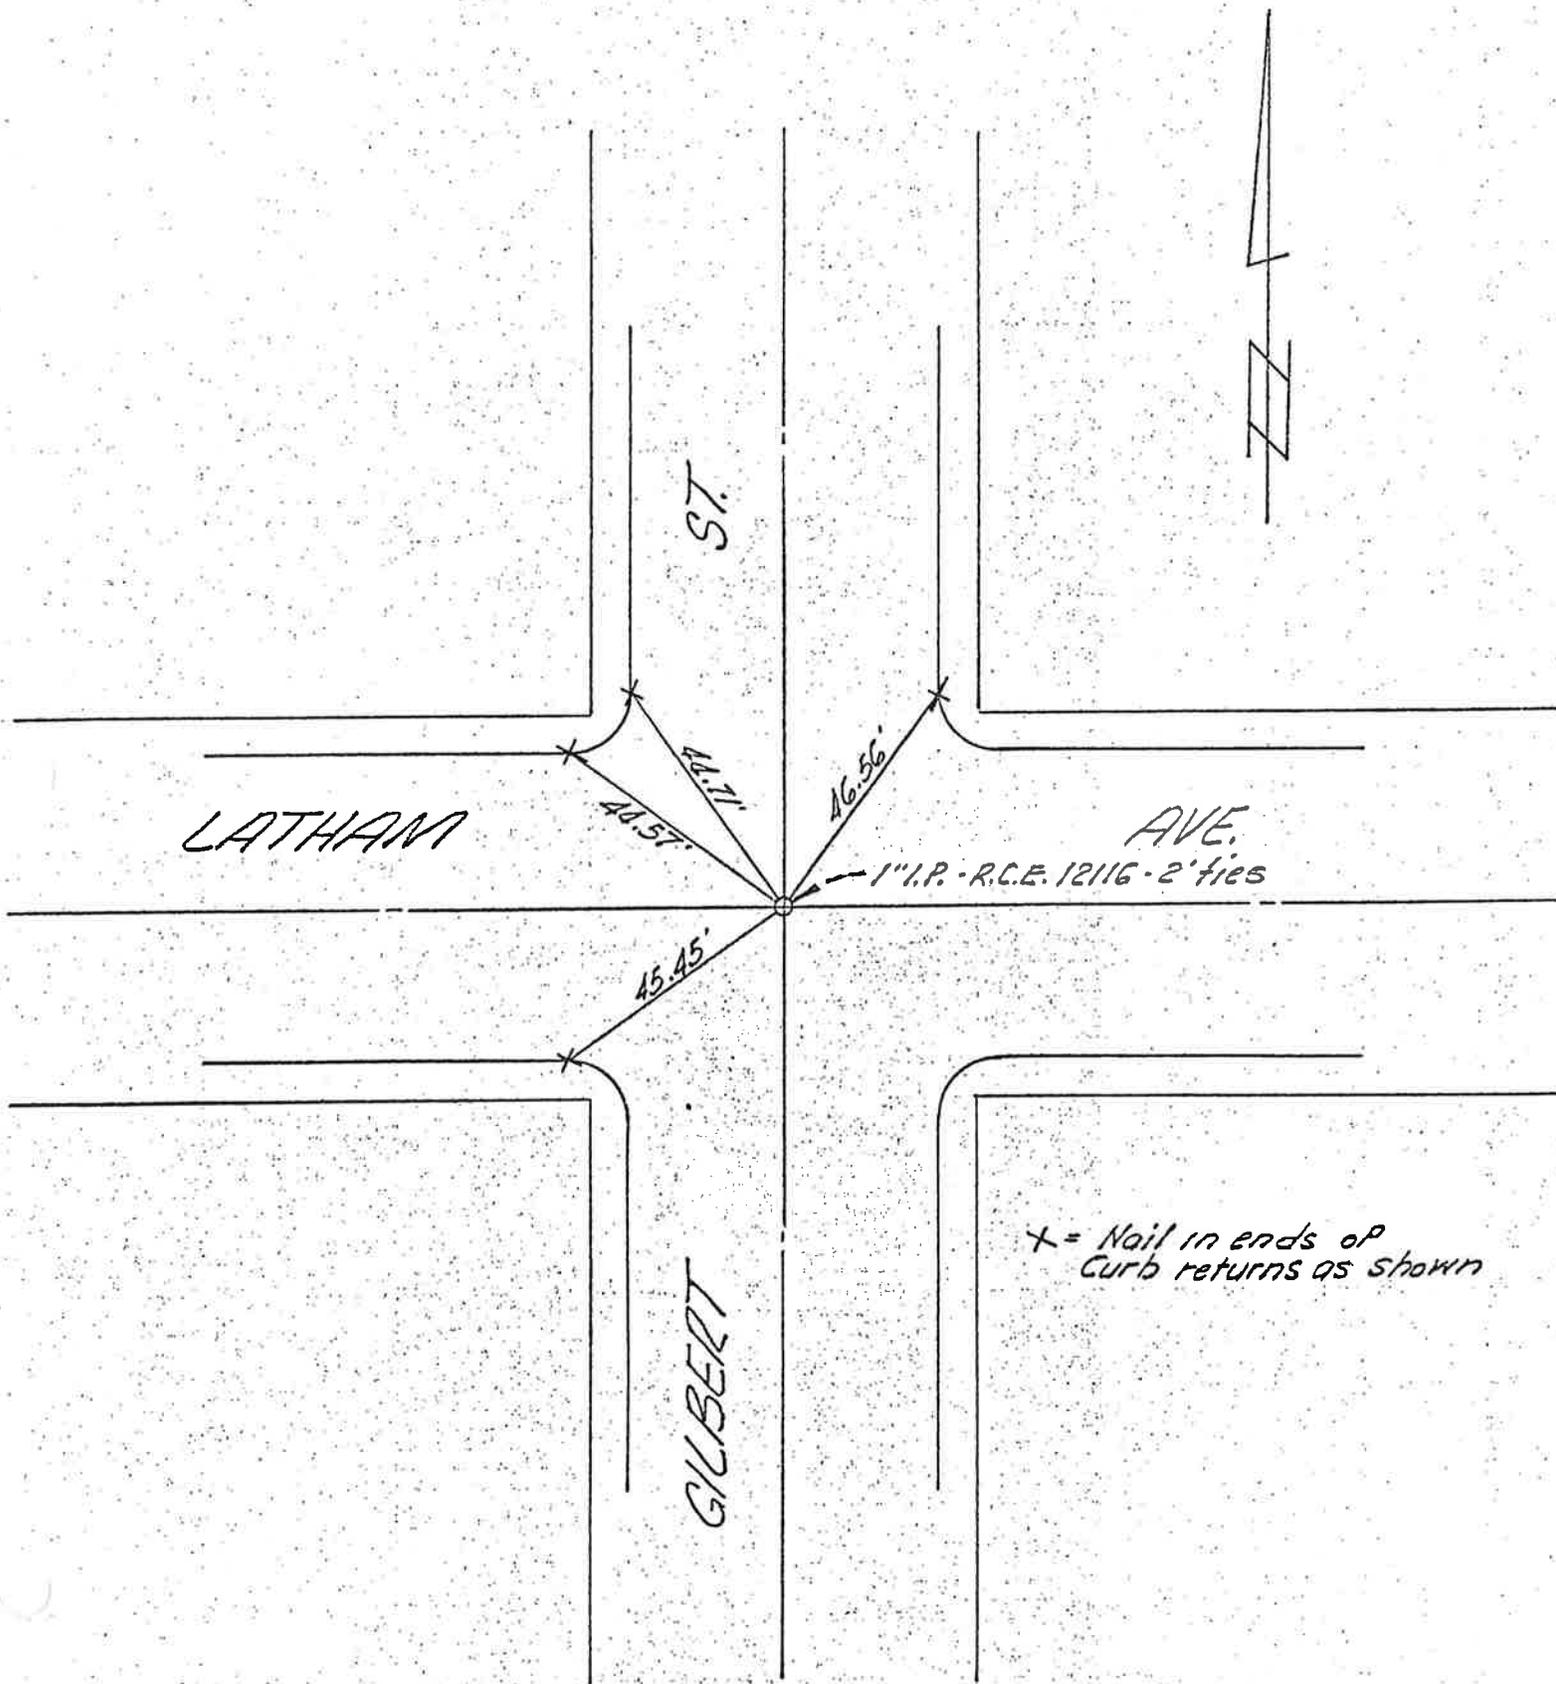

BY FRH

DATE 6/28/66


Ties to Latham Ave.,

Ramona St.

Dist. 64-2

SHEET NO.

JOB NO. 59-067-002-16

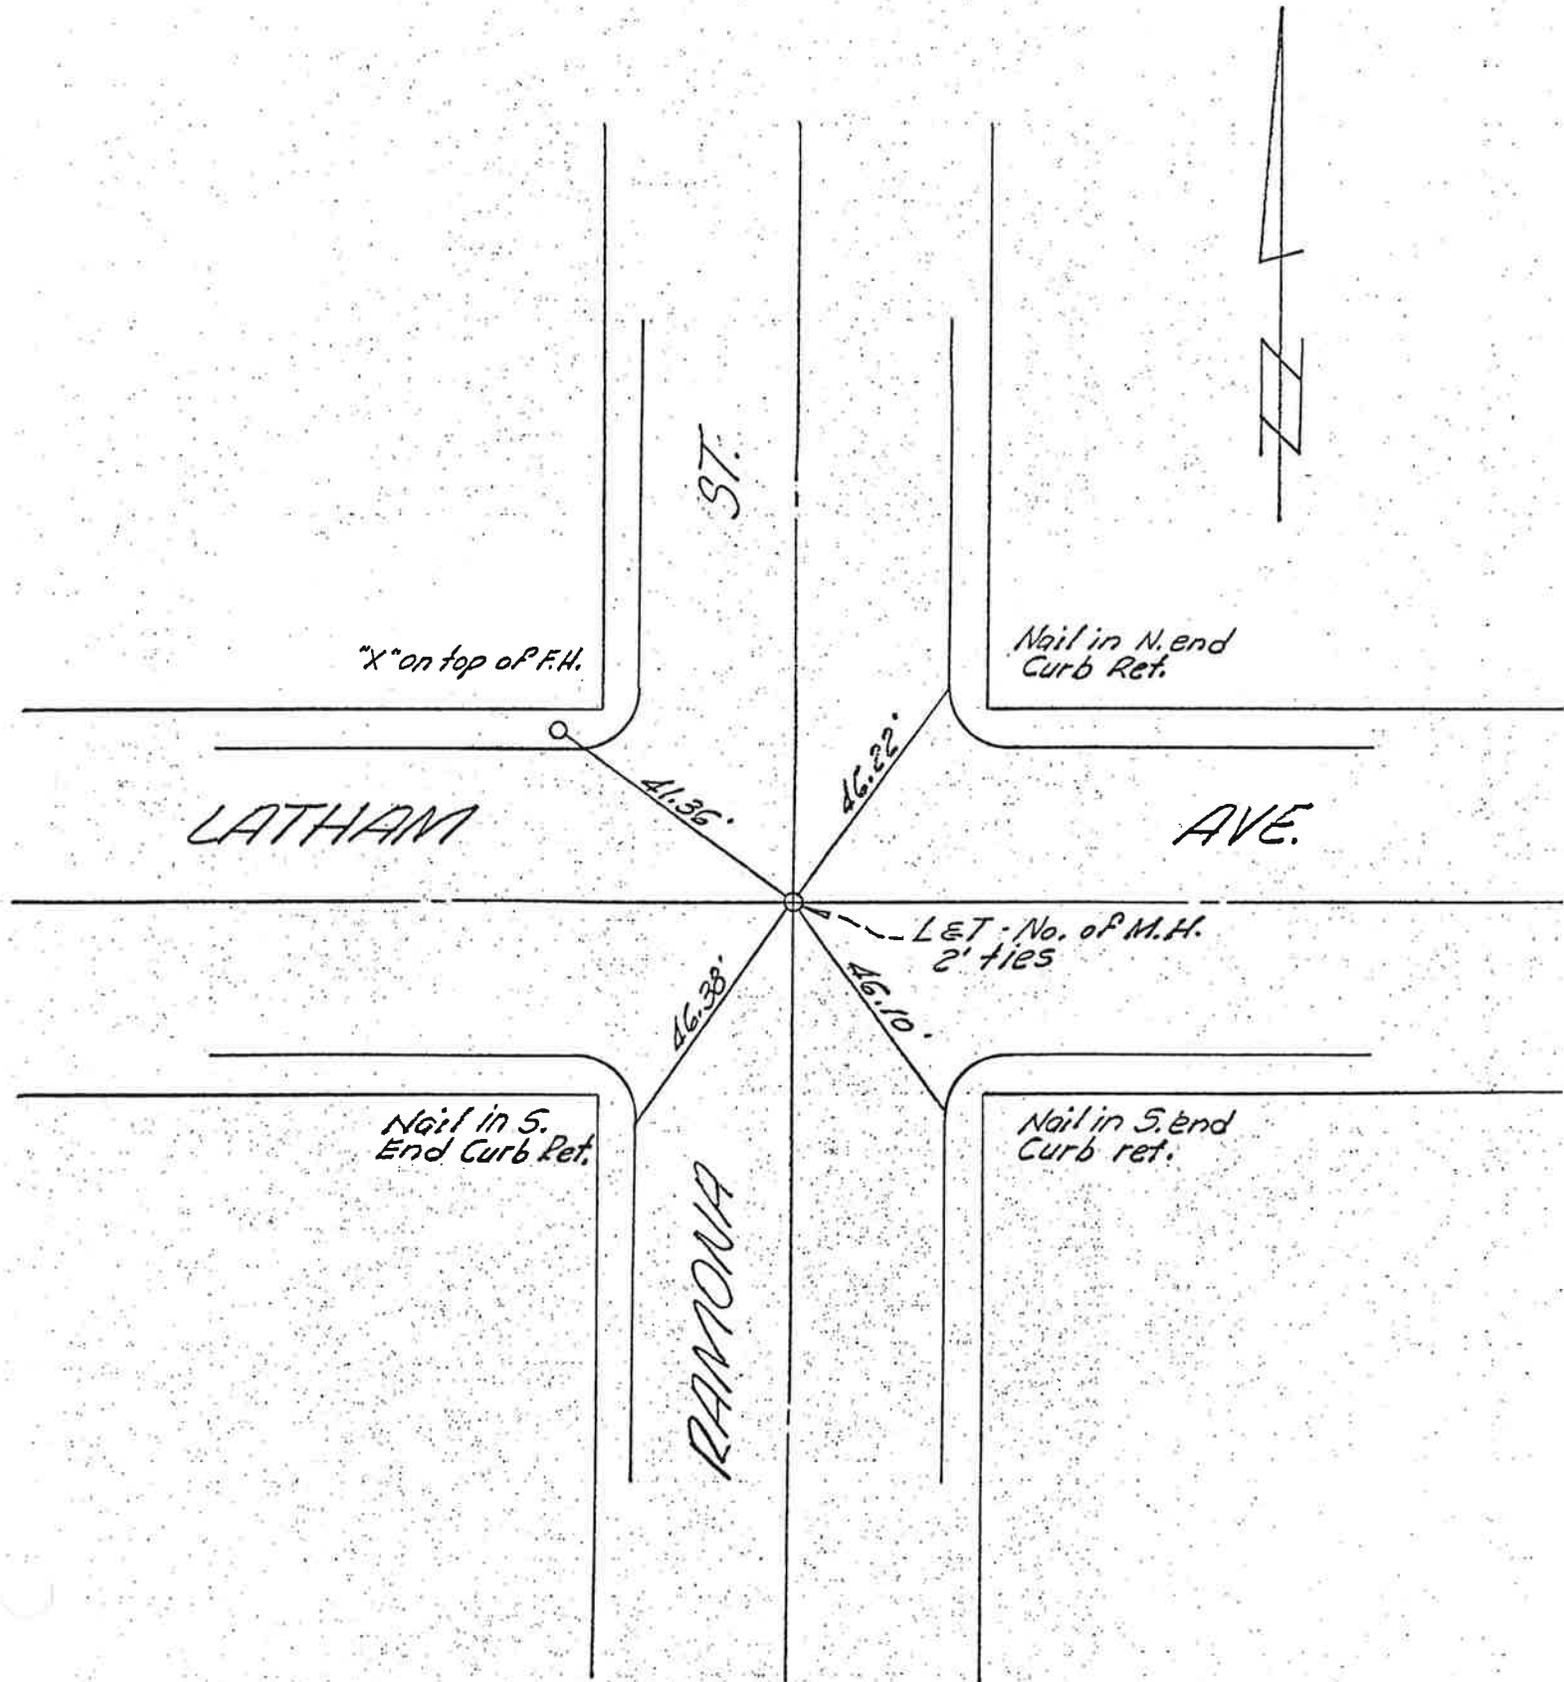

BY *FRH* DATE *6/28/6*

TIES TO *Devonshire Ave*
Ramona St.
Dist. 64-2

SHEET NO. *59-067-002-16*

DEVONSHIRE

AVE.

20.41'

37.62'

37.48'

RAMONA


ST.

x = Nail in Curb




BY FRH DATE 6/22/66 SUBJECT Ties to Latham Ave
CHKD. BY _____ DATE _____ 1. McQuinn St.
Dial 544

SHEET NO. _____ OF _____
JOB NO. 29-167-04-6

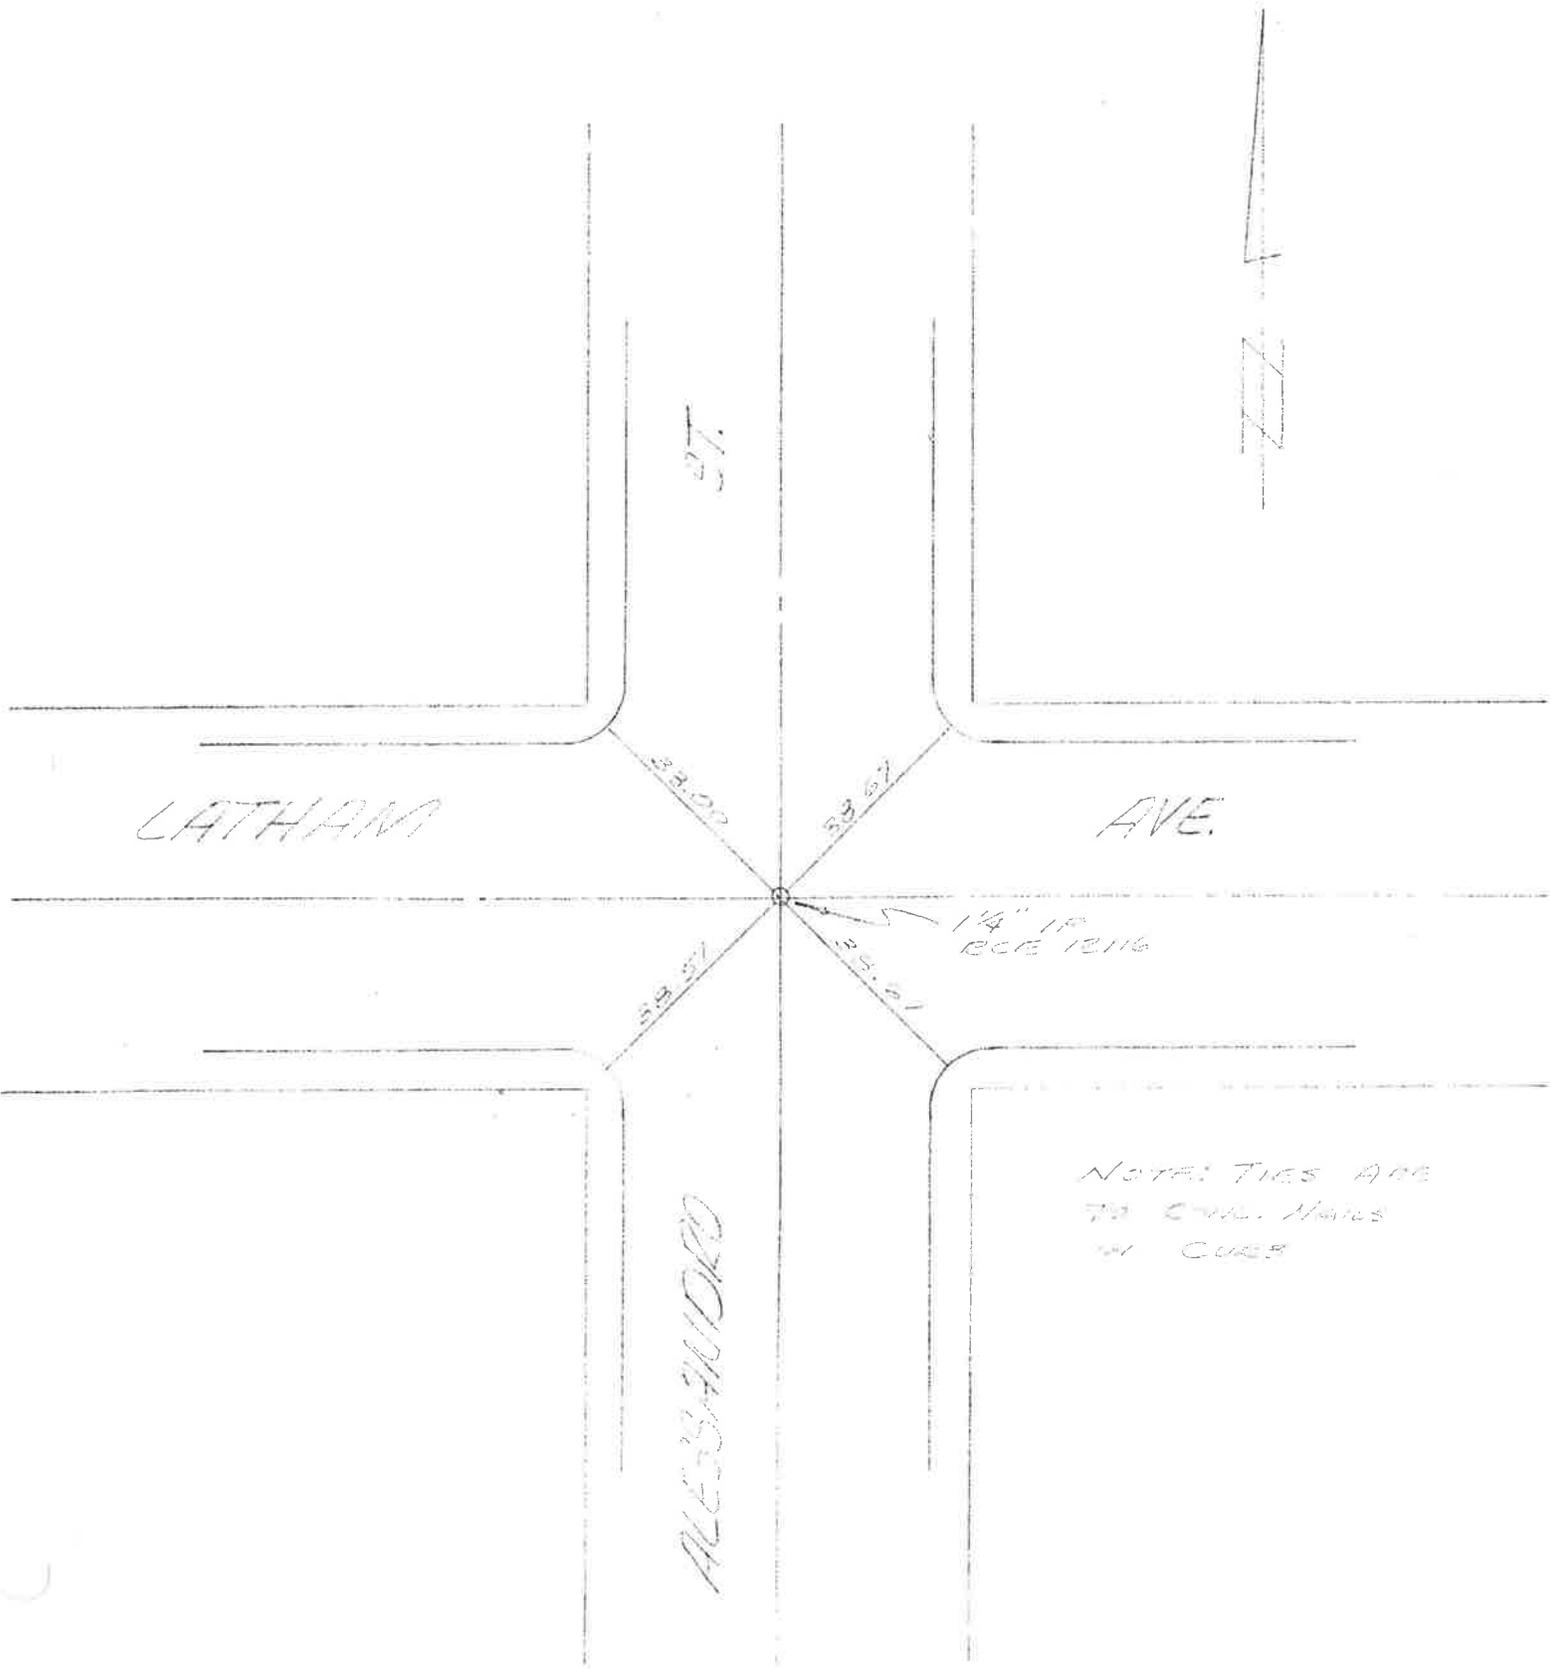

BY EKL DATE 9/2/68 SUBJECT 1/2" to Devonshire Ave SHEET NO. _____ OF _____
CHKD. BY _____ DATE _____ 1/2" to Devonshire Ave JOB NO. 50-237-201
_____ Dist. 68-6 _____

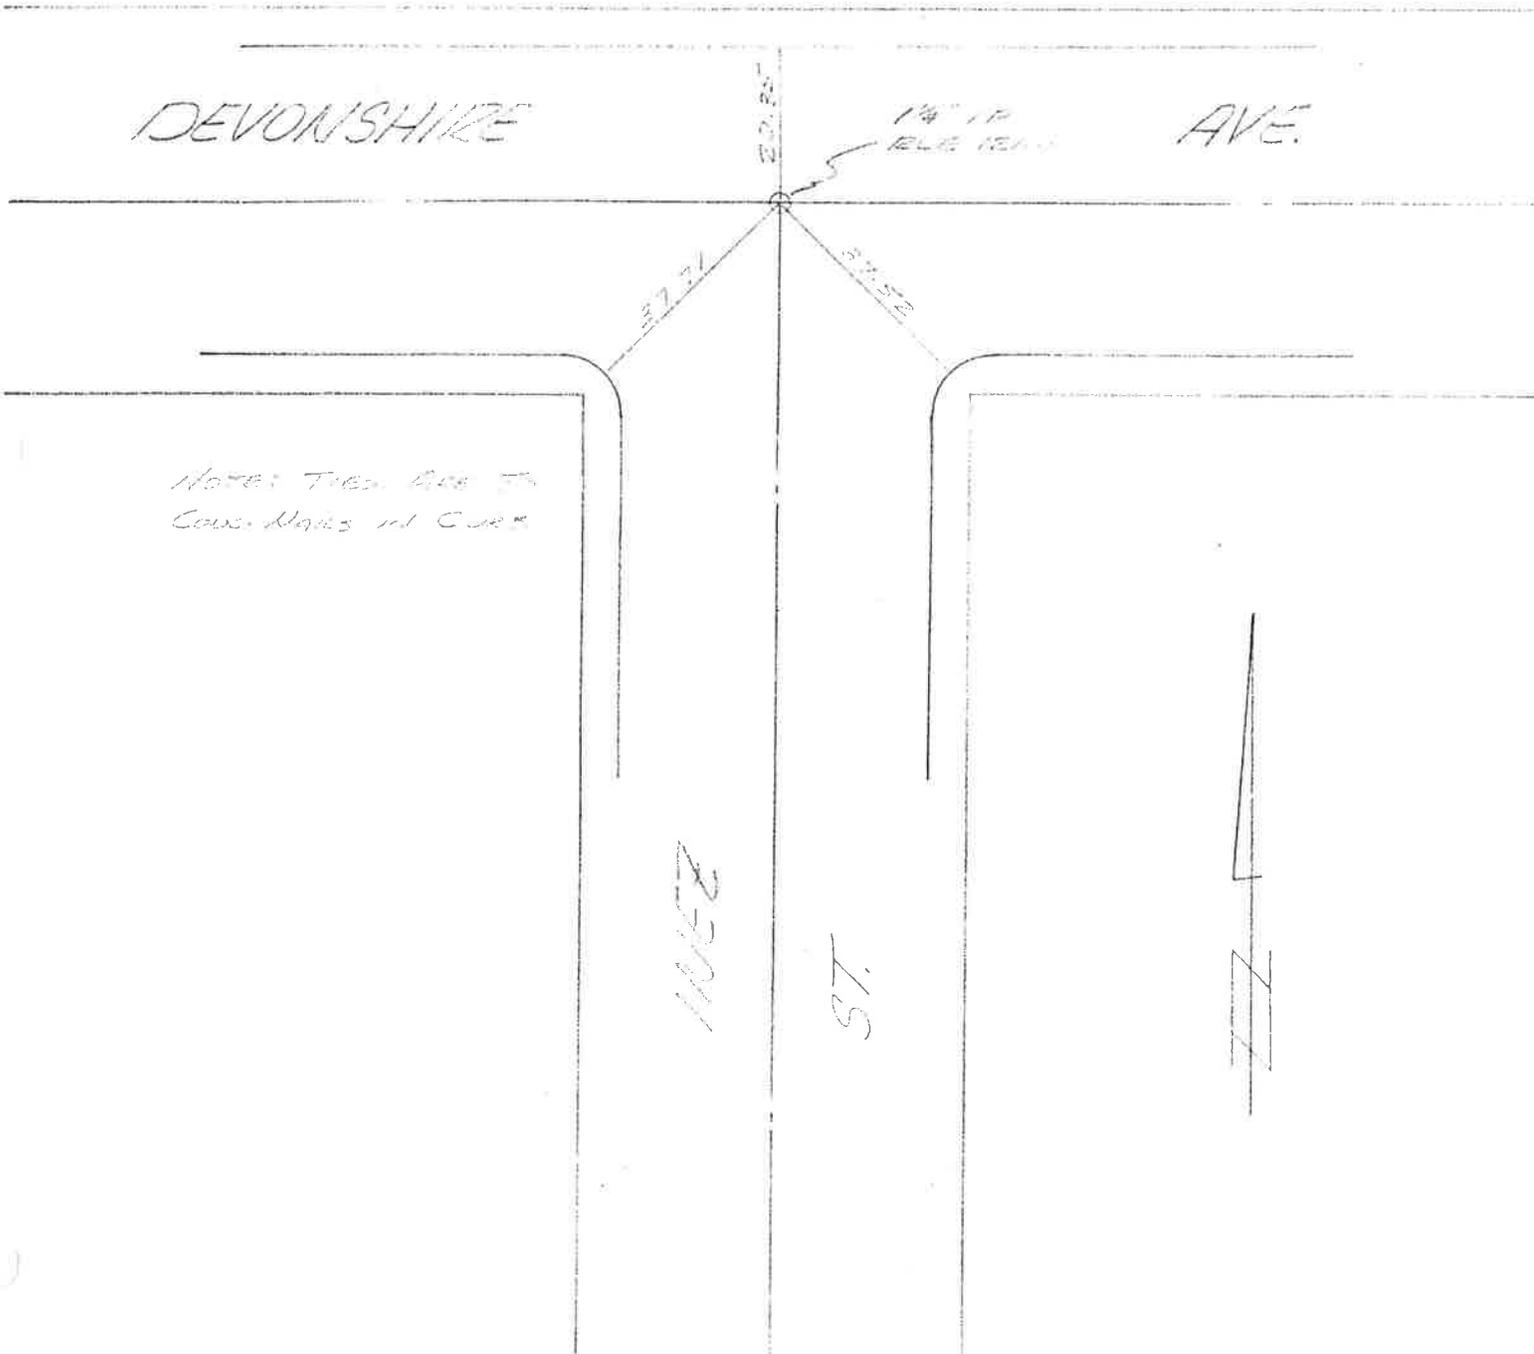

BY TFM DATE 6/2/06


SUBJECT Ties to Devonshire Av. &

SHEET NO. _____ OF _____
JOB NO. 59-067-004-16

CHKD. BY _____ DATE _____

Ramona St.

Dist. 64-4

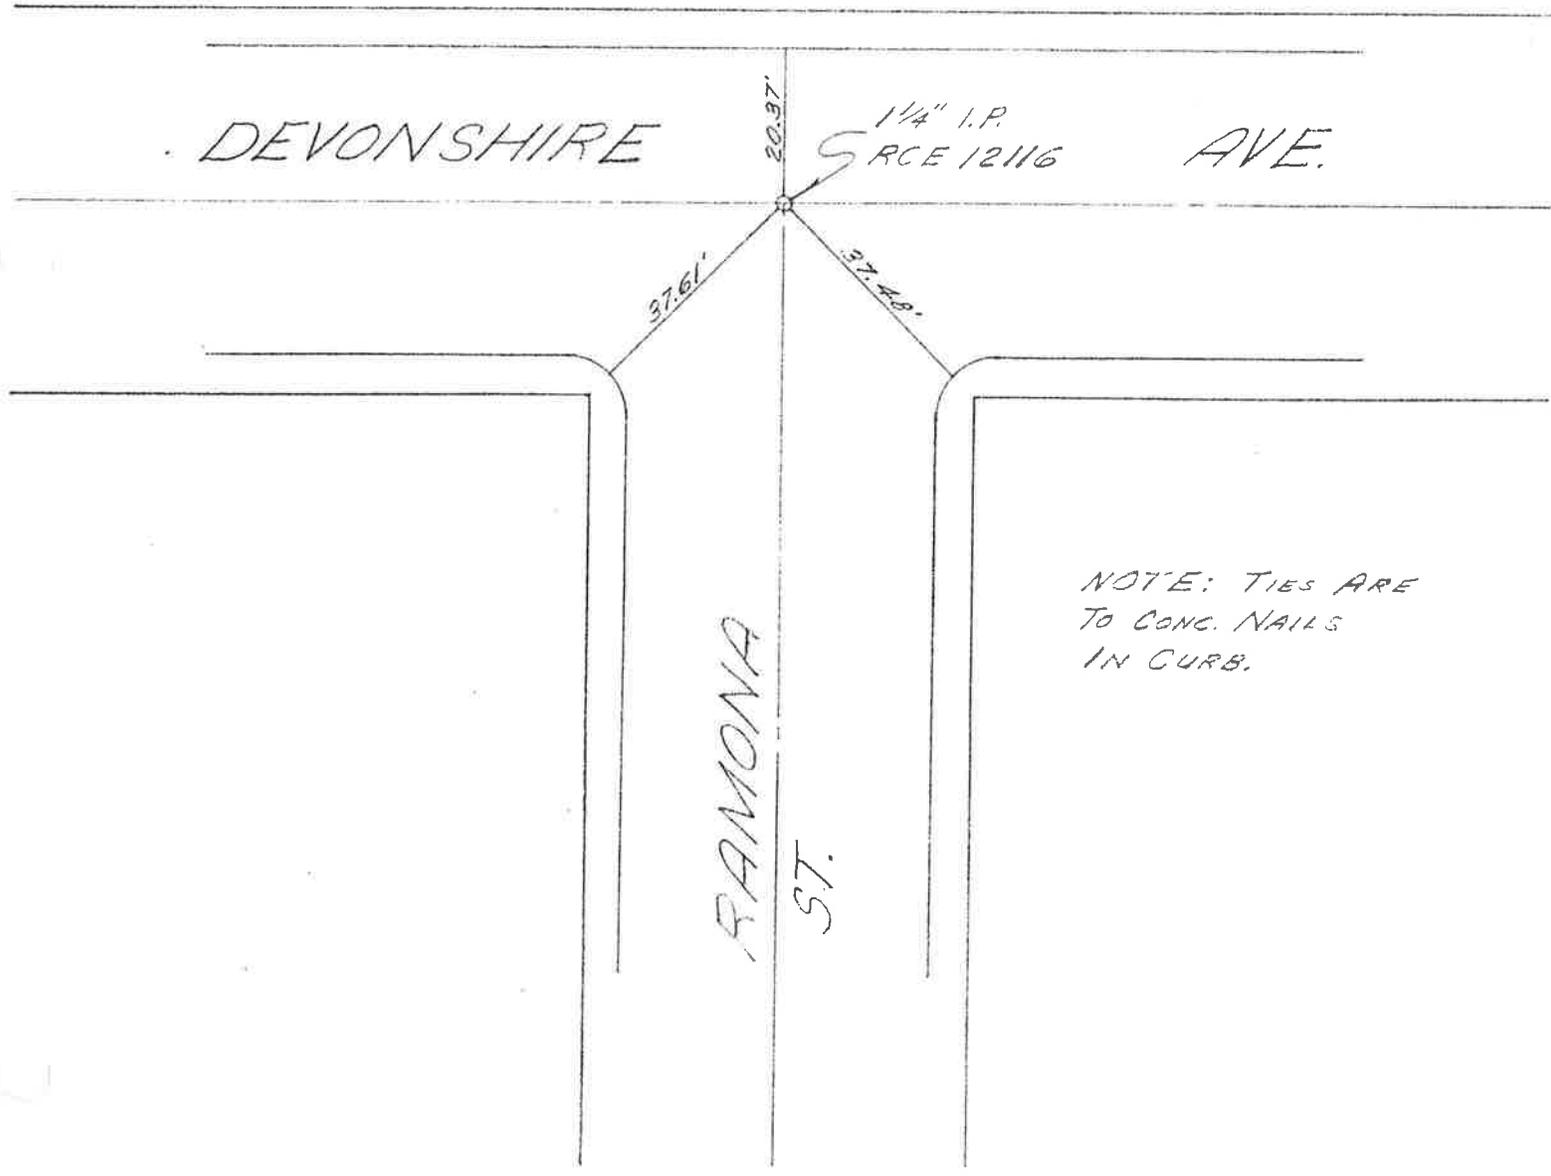

FRH

6/28/66

Ties to Devonshire H. 1.8'
Gilbert St.
Dist. 64-2

59-067-002-16

